

WATER WELL PLUGGING RECORD Form WWC-5P

KSA 82a-1212 ID NO.

MW#2


1 LOCATION OF WATER WELL: Fraction 1/4 SW 1/4 SW 1/4 SW 1/4 Section Number 14 Township Number T 11 S Range Number 33 E W
 County: LOGAN

Street/Rural Address of Well Location; if unknown, distance & direction from nearest town or intersection: If at owner's address, check here NEC CEDAR CREST & CR 380 OAKLEY, KANSAS

Global Positioning Systems (GPS) Information:
 Latitude: 39.09029 (in decimal degrees)
 Longitude: -100.96059 (in decimal degrees)
 Elevation: 3137
 Datum: WGS84, NAD83, NAD27
 Collection Method:

2 WATER WELL OWNER: PLAINS ALL AMERICAN
 RR#, St. Address, Box #: P.O. BOX 4648
 City, State ZIP Code: HOUSTON, TX 77210

GPS unit (Make/Model: _____)
 Digital Map/Photo, Topographic Map, Land Survey
 Est. Accuracy: <3 m, 3-5 m, 5-15 m, >15 m

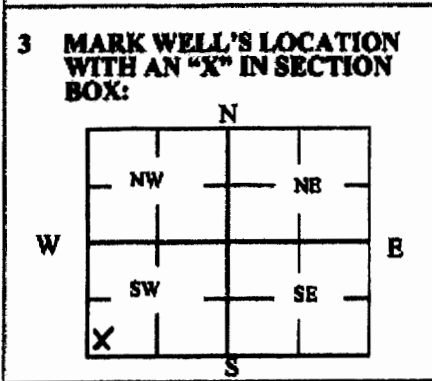

4 DEPTH OF WELL 153 ft.
 WELL'S STATIC WATER LEVEL 145 ft.
 WELL WAS USED AS:
 Domestic Irrigation Public Water Supply Dewatering
 Feedlot Oil Field Water Supply Monitoring
 Industrial Domestic (Lawn & Garden) Injection Well
 Air Conditioning Other _____
 Was a chemical/bacteriological sample submitted to Department? Yes No

5 TYPE OF BLANK CASING USED:
 Steel RMP (SR) Wrought Fiberglass Other (Specify below)
 PVC ABS Asbestos-Cement Concrete Tile
 Blank casing diameter 4.5 in. Was casing pulled? Yes No If yes, how much 3 FT (below grade)
 Casing height above or below land surface 36 in.

6 GROUT PLUG MATERIAL: Neat cement Cement grout Bentonite Other _____
 Grout Plug Intervals: From 0 ft. to 153 ft., From _____ ft. to _____ ft., From _____ ft. to _____ ft.
 What is the nearest source of possible contamination:
 Septic tank Seepage pit Fuel storage Other (specify below)
 Sewer lines Pit privy Fertilizer storage
 Watertight sewer lines Sewage lagoon Insecticide storage
 Lateral lines Feedyard Abandoned water well Direction from well? _____
 Cess pool Livestock pens Oil well/Gas well How many feet? _____

FROM	TO	PLUGGING MATERIALS	FROM	TO	PLUGGING MATERIALS
10	153	BENTONITE			
0	10	SAND			

7 CONTRACTOR'S OR LANDOWNER'S CERTIFICATION: This water well was plugged under my jurisdiction and was completed on (mo/day/year) 12/16/2013 and this record is true to the best of my knowledge and belief. Kansas Water Well Contractor's License No. 416. This Water Well Record was completed on (mo/day/year) 12/18/2013 under the business name of TERRACON CONSULTANTS INC by (signature) _____

INSTRUCTIONS: Use typewriter or ballpoint pen. Please press firmly and print clearly. Please fill in blanks, underline or circle the correct answers. Send top three copies to Kansas Department of Health and Environment, Bureau of Water, Geology Section, 1000 SW Jackson St., Ste. 420, Topeka, Kansas 66612-1367. Telephone: 785/296-5524. Send one to Water Well Owner and retain one for your records. Visit us at <http://www.kdheks.gov/waterwell/index.html>.