


1 LOCATION OF WATER WELL: Fraction **SE 1/4 NW 1/4 SE 1/4** Section Number **26** Township Number **T 11 S** Range Number **R 34 E (W)**
 County: **Logan**
 Distance and direction from nearest town or city street address of well if located within city?

2 WATER WELL OWNER: **Larry Scheetz**
 RR#, St. Address, Box #: **2304 Broken Bow** Board of Agriculture, Division of Water Resources
 City, State, ZIP Code: **Monument, Ks 67747** Application Number: **20070098**

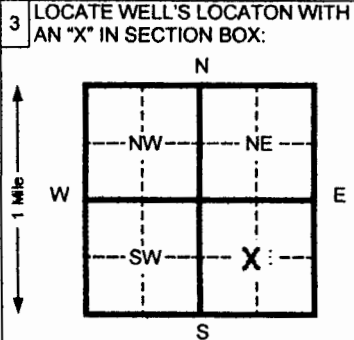

4 DEPTH OF COMPLETED WELL **153** ft. ELEVATION: _____
 Depth(s) Groundwater Encountered 1 _____ ft. 2 _____ ft. 3 _____ ft.
 WELL'S STATIC WATER LEVEL **na** ft. below land surface measured on mo/day/yr
 Pump test data: Well water was _____ ft. after _____ hours pumping _____ gpm
 Est. Yield _____ gpm: Well water was _____ ft. after _____ hours pumping _____ gpm
 Bore Hole Diameter **8** in. to **160** ft. and _____ in. to _____ ft.
 WELL WATER TO BE USED AS: Public water supply Air conditioning Injection well
 Domestic Feed lot Oil field water supply Dewatering Other (Specify below)
 Irrigation Industrial Lawn and garden (domestic) Monitoring well
 Was a chemical/bacteriological sample submitted to Department? Yes _____ No If yes, mo/day/yr sample was submitted _____
 Water Well Disinfected? Yes No _____

5 TYPE OF BLANK CASING USED: 1 Steel 3 RMP (SR) 5 Wrought iron 8 Concrete tile CASING JOINTS: Glued Clamped
 PVC 4 ABS 6 Asbestos-Cement 9 Other (specify below) Welded _____
 7 Fiberglass Threaded _____
 Blank casing diameter **4.5** in. to **113** ft., Dia _____ in. to _____ ft., Dia _____ in. to _____ ft.
 Casing height above land surface **18** in., weight **2.38** lbs./ft. Wall thickness or gauge No. **.248**
 TYPE OF SCREEN OR PERFORATION MATERIAL: PVC 10 Asbestos-cement
 1 Steel 3 Stainless steel 5 Fiberglass 8 RMP (SR) 11 Other (specify) _____
 2 Brass 4 Galvanized steel 6 Concrete tile 9 ABS 12 None used (open hole)
 SCREEN OR PERFORATION OPENINGS ARE: 5 Gauzed wrapped Saw cut 11 None (open hole)
 1 Continuous slot 3 Mill slot 6 Wire wrapped 9 Drilled holes
 2 Louvered shutter 4 Key punched 7 Torch cut 10 Other (specify) _____
 SCREEN-PERFORATED INTERVALS: From **113** ft. to **153** ft. From _____ ft. to _____ ft.
 From _____ ft. to _____ ft. From _____ ft. to _____ ft.
 GRAVEL PACK INTERVALS: From **20** ft. to **153** ft. From _____ ft. to _____ ft.
 From _____ ft. to _____ ft. From _____ ft. to _____ ft.

6 GROUT MATERIAL: 1 Neat cement 2 Cement grout Bentonite 4 Other _____
 Grout Intervals From **0** ft. to **20** ft. From _____ ft. to _____ ft. From _____ ft. to _____ ft.
 What is the nearest source of possible contamination:
 1 Septic tank 4 Lateral lines 7 Pit privy 10 Livestock pens 14 Abandoned water well
 2 Sewer lines 5 Cess pool 8 Sewage lagoon 11 Fuel storage 15 Oil well/ Gas well
 3 Watertight sewer lines 6 Seepage pit 9 Feedyard 12 Fertilizer storage 16 Other (specify below)
 13 Insecticide storage **none**

Direction from well? _____ How many feet? _____

FROM	TO	CODE	LITHOLOGIC LOG	FROM	TO	PLUGGING INTERVALS
0	2		Surface	102	120	Clay
2	10		Loess	120	124	Clay w/a few fine sd strks
10	18		Fine sand	124	125	Sand
18	21		Med sd	125	127	Caliche
21	30		Fine sand (tight)	127	128	Fine to some med sd.
30	33		Fine sand	128	135	Clay w/a few fine sd lens
33	36		Clay	135	147	Fine to med sand
36	56		Fine to med	147	150	Clay
56	68		Clay	150	154	Fine to med sand
68	73		Fine to some med sd w/claystrk	154	160	Yellow ochre & gray shale
73	75		Clay			
75	92		Fine to some med sand			
92	96		Clay			
96	102		Clay w/sand strks			

7 CONTRACTOR'S OR LANDOWNER'S CERTIFICATION: This water well was (1) constructed, (2) reconstructed, or (3) plugged under my jurisdiction and was completed on (mo/day/yr) **03-27-07** and this record is true to the best of my knowledge and belief. Kansas
 Water Well Contractor's License No. **554** This Water Well Record was completed on (mo/day/yr) **03-28-07**
 under the business name of **Woofter Pump & Well Inc.** by (signature) *Jay C. Woofter, Jr. MR*

OFFICE USE ONLY

T
R

SEC