


1 LOCATION OF WATER WELL:	Fraction <i>SE NW NE</i>	Section Number	Township Number	Range Number
County: <b>Logan</b>	<del>NW 1/4 NE 1/4 NE 1/4</del>	<b>24</b>	<b>11</b>	<b>35</b>

Distance and direction from nearest town or city street address of well if located within city?

2 WATER WELL OWNER: **Cooperative Agricultural Services, Inc.**  
 RR#, St. Address, Box # **411 West 2<sup>nd</sup> St.**  
 City, State, ZIP Code : **Oakley, KS 67748**  
 Board of Agriculture, Division of Water Resources  
 Application Number:

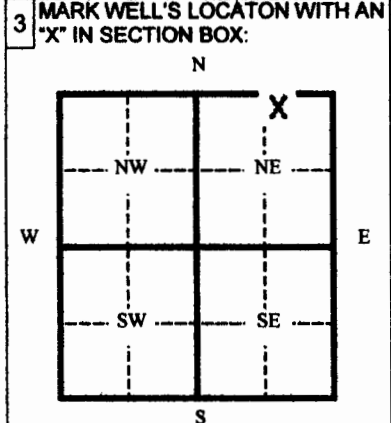

4 DEPTH OF WELL **110** ft.  
 WELL'S STATIC WATER LEVEL **101.4** ft.  
 WELL WAS USED AS:  
 1 Domestic                      5 Public Water Supply                      9 Dewatering  
 2 Irrigation                      6 Oil Field Water Supply                       10 Monitoring Well  
 3 Feedlot                          7 Lawn and Garden (domestic)                      11 Injection Well  
 4 Industrial                      8 Air Conditioning                          12 Other \_\_\_\_\_  
 Was a chemical/bacteriological sample submitted to Department? Yes \_\_\_\_\_ No   
 If yes, mo/day/yr sample was submitted \_\_\_\_\_  
 Water Well Disinfected: Yes \_\_\_\_\_ No

5 TYPE OF BLANK CASING USED:  
 1 Steel                      3 RMP (SR)                      5 Wrought                      7 Fiberglass                      9 Other (specify below)  
 2 PVC                      4 ABC                      6 Asbestos-Cement                      8 Concrete Tile  
 Blank casing diameter **4** in. Was casing pulled? Yes  No \_\_\_\_\_ If yes, how much **3 FT**  
 Casing height above or below land surface **0** in.

6 GROUT PLUG MATERIAL: 1 Neat cement    2 Cement grout     3 Bentonite    4 Other \_\_\_\_\_  
 Grout Plug Intervals From **95** ft. to **0** ft. From \_\_\_\_\_ ft. to \_\_\_\_\_ ft. From \_\_\_\_\_ ft. to \_\_\_\_\_ ft.  
 What is the nearest source of possible contamination:  
 1 Septic tank                      6 Seepage pit                      11 Fuel storage                      16 Other (specify below)  
 2 Sewer lines                      7 Pit privy                      12 Fertilizer storage  
 3 Watertight sewer lines                      8 Sewage lagoon                      13 Insecticide storage  
 4 Lateral lines                      9 Feedyard                      14 Abandoned water well  
 5 Cess Pool                      10 Livestock pens                      15 Oil well/ Gas well  
 Direction from well? \_\_\_\_\_ How many feet? \_\_\_\_\_

FROM	TO	CODE	PLUGGING MATERIALS
108	95		BENTONITE CHIPS
95	0		BENTONITE - Pumpable Tremmled
			Drilled out top 3' of casing & removed well
			Vaults & concrete pads

7 CONTRACTOR'S OR LANDOWNER'S CERTIFICATION: This water well was plugged under my jurisdiction and was completed on (mo/day/yr) **9-20-05** and this record is true to the best of my knowledge and belief. Kansas Water Well Contractor's License No. **554** This Water Well Record was completed on (mo/day/yr) **9-30-05** under the business name of **Woofter Pump & Well Inc.**  
 by (signature) *[Signature]*

INSTRUCTIONS: Please fill in blanks and circle the correct answers. Send three copies to Kansas Department of Health and Environment, Bureau of Water, 1000 S W Jackson St., Ste. 420, Topeka, Kansas 66620-0001. Telephone: 785-296-3565. Send one to Water Well Owner and retain one for your records.

Logan

24-11-35

WELL_ID	SPOT	LONGITUDE	LATITUDE	LONG_LAT_TYPE	OWNER	STATUS	OTHER_ID
93268	SE NW NE	-101.151829	39.087857	LEO by Hand	Mingo Coop Grain Co.	CONSTRUCTED	MW 4
376355	SE NW NE	-101.151829	39.087857	LEO by Hand	Cooperative Agricultural Services, Inc.	PLUGGED	MW 4
93267	SE NW NE	-101.152102	39.087908	LEO by Hand	Mingo Coop Grain Co.	CONSTRUCTED	MW 5
376351	SE NW NE	-101.152102	39.087908	LEO by Hand	Cooperative Agricultural Services, Inc.	PLUGGED	MW 5
93266	SE NW NE	-101.152174	39.087821	LEO by Hand	Mingo Coop Grain Co.	CONSTRUCTED	MW 6
376354	SE NW NE	-101.152174	39.087821	LEO by Hand	Cooperative Agricultural Services, Inc.	PLUGGED	MW 6
93265	SE NW NE	-101.152253	39.087976	LEO by Hand	Mingo Coop Grain Co.	CONSTRUCTED	MW 7
376352	SE NW NE	-101.152253	39.087976	LEO by Hand	Cooperative Agricultural Services, Inc.	PLUGGED	MW 7
93264	SE NW NE	-101.151549	39.087908	LEO by Hand	Mingo Coop Grain Co.	CONSTRUCTED	MW 8
93263	SE NW NE	-101.152581	39.087737	LEO by Hand	Mingo Coop Grain Co.	CONSTRUCTED	MW 9
376353	SE NW NE	-101.152581	39.087737	LEO by Hand	Cooperative Agricultural Services, Inc.	PLUGGED	MW 9