


1 LOCATION OF WATER WELL: Fraction <u>SE NW NE</u>	Section Number <u>24</u>	Township Number <u>11</u>	Range Number <u>35</u>
County: <u>Logan</u>	<u>NW 1/4 NE 1/4 NE 1/4</u>		

Distance and direction from nearest town or city street address of well if located within city?

2 WATER WELL OWNER: **Cooperative Agricultural Services, Inc.**
 RR#, St. Address, Box # **411 West 2nd St.** Board of Agriculture, Division of Water Resources
 City, State, ZIP Code : **Oakley, KS 67748** Application Number:

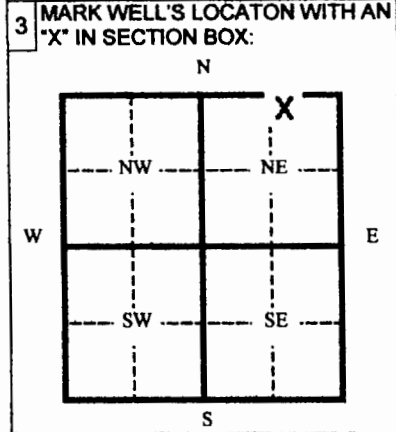

4 DEPTH OF WELL 107 ft.
 WELL'S STATIC WATER LEVEL 99.93 ft.
 WELL WAS USED AS:
 1 Domestic 5 Public Water Supply 9 Dewatering
 2 Irrigation 6 Oil Field Water Supply 10 Monitoring Well
 3 Feedlot 7 Lawn and Garden (domestic) 11 Injection Well
 4 Industrial 8 Air Conditioning 12 Other _____

Was a chemical/bacteriological sample submitted to Department? Yes _____ No X
 If yes, mo/day/yr sample was submitted _____
 Water Well Disinfected: Yes _____ No X

5 TYPE OF BLANK CASING USED:
 1 Steel 3 RMP (SR) 5 Wrought 7 Fiberglass 9 Other (specify below)
 2 PVC 4 ABC 6 Asbestos-Cement 8 Concrete Tile

Blank casing diameter 4 in. Was casing pulled? Yes X No _____ If yes, how much 3 FT
 Casing height above or below land surface 0 in.

6 GROUT PLUG MATERIAL: 1 Neat cement 2 Cement grout 3 Bentonite 4 Other _____

Grout Plug Intervals From 92 ft. to 0 ft. From _____ ft. to _____ ft. From _____ ft. to _____ ft.

What is the nearest source of possible contamination:
 1 Septic tank 6 Seepage pit 11 Fuel storage 16 Other (specify below)
 2 Sewer lines 7 Pit privy 12 Fertilizer storage
 3 Watertight sewer lines 8 Sewage lagoon 13 Insecticide storage
 4 Lateral lines 9 Feedyard 14 Abandoned water well
 5 Cess Pool 10 Livestock pens 15 Oil well/ Gas well

Direction from well? _____ How many feet? _____

FROM	TO	CODE	PLUGGING MATERIALS
108	92		BENTONITE CHIPS
92	0		BENTONITE - Pumpable Tremmied
			Drilled out top 3' of casing & removed well
			Vaults & concrete pads

7 CONTRACTOR'S OR LANDOWNER'S CERTIFICATION: This water well was plugged under my jurisdiction and was completed on (mo/day/yr) 9-20-05 and this record is true to the best of my knowledge and belief. Kansas Water Well Contractor's License No. 554 This Water Well Record was completed on (mo/day/yr) 9-30-05 under the business name of Woofter Pump & Well Inc.
 by (signature) Gary C. Woofter

INSTRUCTIONS: Please fill in blanks and circle the correct answers. Send three copies to Kansas Department of Health and Environment, Bureau of Water, 1000 S W Jackson St., Ste. 420, Topeka, Kansas 66620-0001. Telephone: 785-296-3565. Send one to Water Well Owner and retain one for your records.

Logan

24-11-35

WELL_ID	SPOT	LONGITUDE	LATITUDE	LONG_LAT_TYPE	OWNER	STATUS	OTHER_ID
93268	SE NW NE	-101.151829	39.087857	LEO by Hand	Mingo Coop Grain Co.	CONSTRUCTED	MW 4
376355	SE NW NE	-101.151829	39.087857	LEO by Hand	Cooperative Agricultural Services, Inc.	PLUGGED	MW 4
93267	SE NW NE	-101.152102	39.087908	LEO by Hand	Mingo Coop Grain Co.	CONSTRUCTED	MW 5
376351	SE NW NE	-101.152102	39.087908	LEO by Hand	Cooperative Agricultural Services, Inc.	PLUGGED	MW 5
93266	SE NW NE	-101.152174	39.087821	LEO by Hand	Mingo Coop Grain Co.	CONSTRUCTED	MW 6
376354	SE NW NE	-101.152174	39.087821	LEO by Hand	Cooperative Agricultural Services, Inc.	PLUGGED	MW 6
93265	SE NW NE	-101.152253	39.087976	LEO by Hand	Mingo Coop Grain Co.	CONSTRUCTED	MW 7
376352	SE NW NE	-101.152253	39.087976	LEO by Hand	Cooperative Agricultural Services, Inc.	PLUGGED	MW 7
93264	SE NW NE	-101.151549	39.087908	LEO by Hand	Mingo Coop Grain Co.	CONSTRUCTED	MW 8
93263	SE NW NE	-101.152581	39.087737	LEO by Hand	Mingo Coop Grain Co.	CONSTRUCTED	MW 9
376353	SE NW NE	-101.152581	39.087737	LEO by Hand	Cooperative Agricultural Services, Inc.	PLUGGED	MW 9