


1 LOCATION OF WATER WELL: Fraction SE NW NE County: Logan NW 1/4 NE 1/4 NE 1/4	Section Number 24	Township Number 11	Range Number 35
---	-----------------------------	------------------------------	---------------------------

Distance and direction from nearest town or city street address of well if located within city?

2 WATER WELL OWNER: **Cooperative Agricultural Services, Inc.**
 RR#, St. Address, Box # **411 West 2nd St.** Board of Agriculture, Division of Water Resources
 City, State, ZIP Code : **Oakley, KS 67748** Application Number:

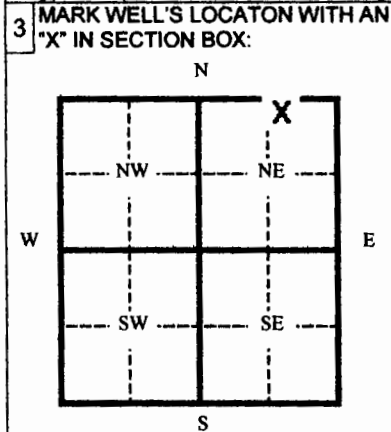

4 DEPTH OF WELL **110** ft.
 WELL'S STATIC WATER LEVEL **101.75** ft.
 WELL WAS USED AS:
 1 Domestic 5 Public Water Supply 9 Dewatering
 2 Irrigation 6 Oil Field Water Supply 10 Monitoring Well
 3 Feedlot 7 Lawn and Garden (domestic) 11 Injection Well
 4 Industrial 8 Air Conditioning 12 Other _____
 Was a chemical/bacteriological sample submitted to Department? Yes _____ No
 If yes, mo/day/yr sample was submitted _____
 Water Well Disinfected: Yes _____ No

5 TYPE OF BLANK CASING USED:
 1 Steel 3 RMP (SR) 5 Wrought 7 Fiberglass 9 Other (specify below)
 2 PVC 4 ABC 6 Asbestos-Cement 8 Concrete Tile
 Blank casing diameter **4** in. Was casing pulled? Yes No _____ If yes, how much **3 FT**
 Casing height above or below land surface **0** in.

6 GROUT PLUG MATERIAL: 1 Neat cement 2 Cement grout 3 Bentonite 4 Other _____
 Grout Plug Intervals From **95** ft. to **0** ft. From _____ ft. to _____ ft. From _____ ft. to _____ ft.
 What is the nearest source of possible contamination:
 1 Septic tank 6 Seepage pit 11 Fuel storage 16 Other (specify below)
 2 Sewer lines 7 Pit privy 12 Fertilizer storage _____
 3 Watertight sewer lines 8 Sewage lagoon 13 Insecticide storage _____
 4 Lateral lines 9 Feedyard 14 Abandoned water well _____
 5 Cess Pool 10 Livestock pens 15 Oil well/ Gas well _____
 Direction from well? _____ How many feet? _____

FROM	TO	CODE	PLUGGING MATERIALS
108	95		BENTONITE CHIPS
95	0		BENTONITE - Pumpable Tremmled
			Drilled out top 3' of casing & removed well
			Vaults & concrete pads

7 CONTRACTOR'S OR LANDOWNER'S CERTIFICATION: This water well was plugged under my jurisdiction and was completed on (mo/day/yr) **9-20-05** and this record is true to the best of my knowledge and belief. Kansas Water Well Contractor's License No. **554** This Water Well Record was completed on (mo/day/yr) **9-30-05** under the business name of **Woofter Pump & Well Inc.**
 by (signature) _____

INSTRUCTIONS: Please fill in blanks and circle the correct answers. Send three copies to Kansas Department of Health and Environment, Bureau of Water, 1000 S W Jackson St., Ste. 420, Topeka, Kansas 66620-0001. Telephone: 785-296-3565. Send one to Water Well Owner and retain one for your records.

Logan

24-11-35

WELL_ID	SPOT	LONGITUDE	LATITUDE	LONG_LAT_TYPE	OWNER	STATUS	OTHER_ID
93268	SE NW NE	-101.151829	39.087857	LEO by Hand	Mingo Coop Grain Co.	CONSTRUCTED	MW 4
376355	SE NW NE	-101.151829	39.087857	LEO by Hand	Cooperative Agricultural Services, Inc.	PLUGGED	MW 4
93267	SE NW NE	-101.152102	39.087908	LEO by Hand	Mingo Coop Grain Co.	CONSTRUCTED	MW 5
376351	SE NW NE	-101.152102	39.087908	LEO by Hand	Cooperative Agricultural Services, Inc.	PLUGGED	MW 5
93266	SE NW NE	-101.152174	39.087821	LEO by Hand	Mingo Coop Grain Co.	CONSTRUCTED	MW 6
376354	SE NW NE	-101.152174	39.087821	LEO by Hand	Cooperative Agricultural Services, Inc.	PLUGGED	MW 6
93265	SE NW NE	-101.152253	39.087976	LEO by Hand	Mingo Coop Grain Co.	CONSTRUCTED	MW 7
376352	SE NW NE	-101.152253	39.087976	LEO by Hand	Cooperative Agricultural Services, Inc.	PLUGGED	MW 7
93264	SE NW NE	-101.151549	39.087908	LEO by Hand	Mingo Coop Grain Co.	CONSTRUCTED	MW 8
93263	SE NW NE	-101.152581	39.087737	LEO by Hand	Mingo Coop Grain Co.	CONSTRUCTED	MW 9
376353	SE NW NE	-101.152581	39.087737	LEO by Hand	Cooperative Agricultural Services, Inc.	PLUGGED	MW 9