


1 LOCATION OF WATER WELL: County: <u>Logan</u>	Fraction <u>SW 1/4 SE 1/4 SE 1/4</u>	Section Number <u>19</u>	Township Number <u>11</u>	Range Number <u>35 E/W</u>
--	---	-----------------------------	------------------------------	-------------------------------

Distance and direction from nearest town or city street address of well if located within city?
1 mile north of Winona

2 WATER WELL OWNER: <u>Kevin Tubbs</u> RR#, St. Address, Box #: <u>7303 Rd. E10</u> City, State ZIP Code: <u>Almena, KS 67622</u>	Global Positioning Systems (decimal degrees, min. of 4 digits) Latitude: _____ Longitude: _____ Elevation: _____ Datum: _____ Data Collection Method: _____
---	---

3 MARK WELL'S LOCATION WITH AN "X" IN SECTION BOX:	4 DEPTH OF WELL <u>75</u> ft. WELL'S STATIC WATER LEVEL <u>57</u> ft. WELL WAS USED AS: <table style="width: 100%;"> <tr> <td>1 Domestic <input checked="" type="checkbox"/></td> <td>5 Public Water Supply</td> <td>9 Dewatering</td> </tr> <tr> <td>2 Irrigation</td> <td>6 Oil Field Water Supply</td> <td>10 Monitoring</td> </tr> <tr> <td>3 Feedlot</td> <td>7 Domestic (Lawn & Garden)</td> <td>11 Injection Well</td> </tr> <tr> <td>4 Industrial</td> <td>8 Air Conditioning</td> <td>12 Other _____</td> </tr> </table> Was a chemical/bacteriological sample submitted to Department? Yes _____ No <input checked="" type="checkbox"/>	1 Domestic <input checked="" type="checkbox"/>	5 Public Water Supply	9 Dewatering	2 Irrigation	6 Oil Field Water Supply	10 Monitoring	3 Feedlot	7 Domestic (Lawn & Garden)	11 Injection Well	4 Industrial	8 Air Conditioning	12 Other _____
1 Domestic <input checked="" type="checkbox"/>	5 Public Water Supply	9 Dewatering											
2 Irrigation	6 Oil Field Water Supply	10 Monitoring											
3 Feedlot	7 Domestic (Lawn & Garden)	11 Injection Well											
4 Industrial	8 Air Conditioning	12 Other _____											

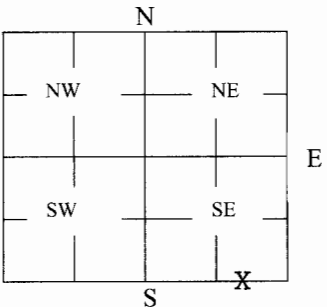

5 TYPE OF BLANK CASING USED:

1 Steel	3 RMP (SR)	5 Wrought	7 Fiberglass	9 Other (Specify below) <input checked="" type="checkbox"/>
2 PVC	4 ABS	6 Asbestos-Cement	8 Concrete Tile	<u>styreen</u>

Blank casing diameter 5 in. Was casing pulled? Yes No _____ in. If yes, how much 20
Casing height above or below land surface 240 in.

6 GROUT PLUG MATERIAL: 1 Neat cement 2 Cement grout 3 Bentonite 4 Other _____

Grout Plug Intervals: From 57 ft. to 47 ft., From 30 ft. to 20 ft., From _____ to _____ ft.

What is the nearest source of possible contamination:

1 Septic tank	6 Seepage pit	11 Fuel Storage	16 Other (specify below) <input checked="" type="checkbox"/>
2 Sewer lines	7 Pit privy	12 Fertilizer storage	<u>farm ground</u>
3 Watertight sewer lines	8 Sewage lagoon	13 Insecticide storage	
4 Lateral lines	9 Feedyard	14 Abandoned water well	Direction from well? <u>all around</u>
5 Cess pool	10 Livestock pens	15 Oil well/Gas well	How many feet? _____

FROM	TO	PLUGGING MATERIALS	FROM	TO	PLUGGING MATERIALS
75	57	gravel			
57	47	grout			
47	30	clean soil			
30	20	grout			
20	0	clean soil			

7 CONTRACTOR'S OR LANDOWNER'S CERTIFICATION: This water well was plugged under my jurisdiction and was completed on (mo/day/year) 3-29-10 and this record is true to the best of my knowledge and belief. Kansas Water Well Contractor's License No. 649. This Water Well Record was completed on (mo/day/year) 4-7-10 under the business name of Bartell Drilling by (signature) Daylene Bartell

INSTRUCTIONS: Use typewriter or ballpoint pen. Please press firmly and print clearly. Please fill in blanks, underline or circle the correct answers. Send top three copies to Kansas Department of Health and Environment, Bureau of Water, Geology Section, 1000 SW Jackson St., Ste. 420, Topeka, Kansas 66612-1367. Telephone: 785/296-5522. Send one to Water Well Owner and retain one for your records. Visit us at <http://www.kdheks.gov/geo/waterwells>.