


1 LOCATION OF WATER WELL: Fraction SE NW NE Section Number 24 Township Number T 11 S Range Number R 35 EW  
 County: LOGAN NE 1/4 NW 1/4 SE 1/4

Distance and direction from nearest town or city street address of well if located within city?  
4337 Feet North AND 1884 Feet West OF THE SOUTHEAST CORNER OF SECTION 24.

2 WATER WELL OWNER: MINING COOP GRAIN COMPANY Board of Agriculture, Division of Water Resources  
 RR#, St. Address, Box #: ROUTE 2, BOX 264 Application Number:  
 City, State, ZIP Code: COLBY, KANSAS 67701

3 LOCATE WELL'S LOCATION WITH AN "X" IN SECTION BOX: 4 DEPTH OF COMPLETED WELL: 108.00 ft. ELEVATION: 3127.64

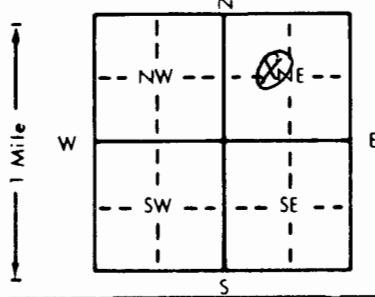

Depth(s) Groundwater Encountered 1. 100.22 ft. 2. ft. 3. ft.  
 WELL'S STATIC WATER LEVEL 100.22 ft. below land surface measured on mo/day/yr 05/13/94  
 Pump test data: Well water was ft. after hours pumping gpm  
 Est. Yield gpm: Well water was ft. after hours pumping gpm  
 Bore Hole Diameter 12.0 in. to 108.00 ft., and in. to ft.  
 WELL WATER TO BE USED AS:  
 5 Public water supply 8 Air conditioning 11 Injection well  
 1 Domestic 3 Feedlot 6 Oil field water supply 9 Dewatering 12 Other (Specify below)  
 2 Irrigation 4 Industrial 7 Lawn and garden only 10 Monitoring well  
 Was a chemical/bacteriological sample submitted to Department? Yes (No) If yes, mo/day/yr sample was submitted  
 Water Well Disinfected? Yes (No)

5 TYPE OF BLANK CASING USED:  
 1 Steel 3 RMP (SR) 5 Wrought iron 8 Concrete tile CASING JOINTS: Glued Clamped  
2 PVC 4 ABS 6 Asbestos-Cement 9 Other (specify below) Welded  
 7 Fiberglass Threaded F.S.  
 Blank casing diameter 4 in. to 76.0 ft. Dia in. to ft. Dia in. to ft.  
 Casing height above land surface -0.27 in. weight lbs./ft. Wall thickness or gauge No. sch 40

TYPE OF SCREEN OR PERFORATION MATERIAL:  
 1 Steel 3 Stainless steel 5 Fiberglass 8 RMP (SR) 10 Asbestos-cement  
 2 Brass 4 Galvanized steel 6 Concrete tile 9 ABS 11 Other (specify)  
 12 None used (open hole)

SCREEN OR PERFORATION OPENINGS ARE:  
 1 Continuous slot 3 Mill slot 5 Gauzed wrapped 8 Saw cut 11 None (open hole)  
 2 Louvered shutter 4 Key punched 6 Wire wrapped 9 Drilled holes  
 7 Torch cut 10 Other (specify)

SCREEN-PERFORATED INTERVALS: From 76.0 ft. to 106.0 ft. From ft. to ft.  
 From ft. to ft. From ft. to ft.  
 GRAVEL PACK INTERVALS: From 74.0 ft. to 108.0 ft. From ft. to ft.  
 From ft. to ft. From ft. to ft.

6 GROUT MATERIAL: 1 Neat cement 2 Cement grout 3 Bentonite 4 Other  
 Grout Intervals: From 0 ft. to 72.0 ft. From ft. to ft. From ft. to ft.

What is the nearest source of possible contamination:  
 1 Septic tank 4 Lateral lines 7 Pit privy 10 Livestock pens 14 Abandoned water well  
 2 Sewer lines 5 Cess pool 8 Sewage lagoon 11 Fuel storage 15 Oil well/Gas well  
 3 Watertight sewer lines 6 Seepage pit 9 Feedyard 12 Fertilizer storage 16 Other (specify below)  
 13 Insecticide storage  
 Direction from well? NORTH How many feet?

FROM	TO	LITHOLOGIC LOG	FROM	TO	PLUGGING INTERVALS
0	47.0	BROWN SILTY CLAY			
47	62	POORLY SORTED SILTY SAND			
62	82	BROWN SANDY SILT			
82	100	REDDISH BROWN MOTTLED SI. CLAY			
100	108	WHITE CAL. CLAY			

7 CONTRACTOR'S OR LANDOWNER'S CERTIFICATION: This water well was (1) constructed, (2) reconstructed, or (3) plugged under my jurisdiction and was completed on (mo/day/year) 05/10/94 and this record is true to the best of my knowledge and belief. Kansas Water Well Contractor's License No. 529 This Water Well Record was completed on (mo/day/yr) 08/12/94 under the business name of GEOTECHNOLOGY, INC. by (signature) H. B. Balduin

Logan

24-11-35

WELL_ID	SPOT	LONGITUDE	LATITUDE	LONG_LAT_TYPE	OWNER	STATUS	OTHER_ID
93268	SE NW NE	-101.151829	39.087857	LEO by Hand	Mingo Coop Grain Co.	CONSTRUCTED	MW 4
376355	SE NW NE	-101.151829	39.087857	LEO by Hand	Cooperative Agricultural Services, Inc.	PLUGGED	MW 4
93267	SE NW NE	-101.152102	39.087908	LEO by Hand	Mingo Coop Grain Co.	CONSTRUCTED	MW 5
376351	SE NW NE	-101.152102	39.087908	LEO by Hand	Cooperative Agricultural Services, Inc.	PLUGGED	MW 5
93266	SE NW NE	-101.152174	39.087821	LEO by Hand	Mingo Coop Grain Co.	CONSTRUCTED	MW 6
376354	SE NW NE	-101.152174	39.087821	LEO by Hand	Cooperative Agricultural Services, Inc.	PLUGGED	MW 6
93265	SE NW NE	-101.152253	39.087976	LEO by Hand	Mingo Coop Grain Co.	CONSTRUCTED	MW 7
376352	SE NW NE	-101.152253	39.087976	LEO by Hand	Cooperative Agricultural Services, Inc.	PLUGGED	MW 7
93264	SE NW NE	-101.151549	39.087908	LEO by Hand	Mingo Coop Grain Co.	CONSTRUCTED	MW 8
93263	SE NW NE	-101.152581	39.087737	LEO by Hand	Mingo Coop Grain Co.	CONSTRUCTED	MW 9
376353	SE NW NE	-101.152581	39.087737	LEO by Hand	Cooperative Agricultural Services, Inc.	PLUGGED	MW 9