


1] LOCATION OF WATER WELL: Fraction SE NW NE Section Number Township Number Range Number
County: LOGAN NE 1/4 NW 1/4 SE 1/4 24 T 11 S R 35 E/W

Distance and direction from nearest town or city street address of well if located within city?
4281 FEET NORTH AND 1861 FEET WEST OF THE SOUTHEAST CORNER OF SECTION 24,

2] WATER WELL OWNER: MINGO COOP GRAIN COMPANY
RR#, St. Address, Box #: ROUTE 2, BOX 264
City, State, ZIP Code: COLBY, KS 67701
Board of Agriculture, Division of Water Resources
Application Number:

3] LOCATE WELL'S LOCATION WITH AN "X" IN SECTION BOX:
4] DEPTH OF COMPLETED WELL: 109.5 ft. ELEVATION: 3125.78

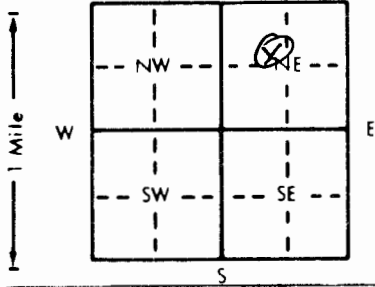

Depth(s) Groundwater Encountered 1. 99.40 ft. 2. ft. 3. ft.
WELL'S STATIC WATER LEVEL 99.40 ft. below land surface measured on mo/day/yr
Pump test data: Well water was ft. after hours pumping gpm
Est. Yield gpm: Well water was ft. after hours pumping gpm
Bore Hole Diameter 12.0 in. to 109.5 ft., and in. to ft.
WELL WATER TO BE USED AS: 5 Public water supply 8 Air conditioning 11 Injection well
1 Domestic 3 Feedlot 6 Oil field water supply 9 Dewatering 12 Other (Specify below)
2 Irrigation 4 Industrial 7 Lawn and garden only 10 Monitoring well
Was a chemical/bacteriological sample submitted to Department? Yes No; If yes, mo/day/yr sample was submitted
Water Well Disinfected? Yes No

5] TYPE OF BLANK CASING USED: 5 Wrought iron 8 Concrete tile CASING JOINTS: Glued Clamped
1 Steel 3 RMP (SR) 6 Asbestos-Cement 9 Other (specify below) Welded
2 PVC 4 ABS 7 Fiberglass Threaded F.J.
Blank casing diameter 4.0 in. to 79.5 ft., Dia. in. to ft., Dia. in. to ft.
Casing height above land surface -0.33 in., weight lbs./ft. Wall thickness or gauge No. SCH 40

TYPE OF SCREEN OR PERFORATION MATERIAL: 7 PVC 10 Asbestos-cement
1 Steel 3 Stainless steel 5 Fiberglass 8 RMP (SR) 11 Other (specify)
2 Brass 4 Galvanized steel 6 Concrete tile 9 ABS 12 None used (open hole)

SCREEN OR PERFORATION OPENINGS ARE: 5 Gauzed wrapped 8 Saw cut 11 None (open hole)
1 Continuous slot 3 Mill slot 6 Wire wrapped 9 Drilled holes
2 Louvered shutter 4 Key punched 7 Torch cut 10 Other (specify)

SCREEN-PERFORATED INTERVALS: From 79.5 ft. to 109.5 ft., From ft. to ft.
From ft. to ft., From ft. to ft.
GRAVEL PACK INTERVALS: From 77.5 ft. to 109.5 ft., From ft. to ft.
From ft. to ft., From ft. to ft.

6] GROUT MATERIAL: 1 Neat cement 2 Cement grout 3 Bentonite 4 Other
Grout Intervals: From 0 ft. to 75.0 ft., From ft. to ft., From ft. to ft.

What is the nearest source of possible contamination:
1 Septic tank 4 Lateral lines 7 Pit privy 10 Livestock pens 14 Abandoned water well
2 Sewer lines 5 Cess pool 8 Sewage lagoon 11 Fuel storage 15 Oil well/Gas well
3 Watertight sewer lines 6 Seepage pit 9 Feedyard 12 Fertilizer storage 16 Other (specify below)
13 Insecticide storage

Direction from well? NORTH How many feet?

Table with columns: FROM, TO, LITHOLOGIC LOG, FROM, TO, PLUGGING INTERVALS. Rows describe geological layers: GRAVEL BACKFILL, BROWN SILTY CLAY, POORLY SORTED SILTY SAND, MOTTLED BROWN SILTY CLAY, POORLY SORTED SAND-SILT., MOTTLED REDDISH BROWN SILTY CLAY, CALICHE - WHITE CLAY.

7] CONTRACTOR'S OR LANDOWNER'S CERTIFICATION: This water well was (1) constructed, (2) reconstructed, or (3) plugged under my jurisdiction and was completed on (mo/day/year) 05-09-94 and this record is true to the best of my knowledge and belief. Kansas Water Well Contractor's License No. 529 This Water Well Record was completed on (mo/day/yr) 08-12-94 under the business name of GEOTECHNOLOGY, INC by (signature) J. Baldean

Logan

24-11-35

WELL_ID	SPOT	LONGITUDE	LATITUDE	LONG_LAT_TYPE	OWNER	STATUS	OTHER_ID
93268	SE NW NE	-101.151829	39.087857	LEO by Hand	Mingo Coop Grain Co.	CONSTRUCTED	MW 4
376355	SE NW NE	-101.151829	39.087857	LEO by Hand	Cooperative Agricultural Services, Inc.	PLUGGED	MW 4
93267	SE NW NE	-101.152102	39.087908	LEO by Hand	Mingo Coop Grain Co.	CONSTRUCTED	MW 5
376351	SE NW NE	-101.152102	39.087908	LEO by Hand	Cooperative Agricultural Services, Inc.	PLUGGED	MW 5
93266	SE NW NE	-101.152174	39.087821	LEO by Hand	Mingo Coop Grain Co.	CONSTRUCTED	MW 6
376354	SE NW NE	-101.152174	39.087821	LEO by Hand	Cooperative Agricultural Services, Inc.	PLUGGED	MW 6
93265	SE NW NE	-101.152253	39.087976	LEO by Hand	Mingo Coop Grain Co.	CONSTRUCTED	MW 7
376352	SE NW NE	-101.152253	39.087976	LEO by Hand	Cooperative Agricultural Services, Inc.	PLUGGED	MW 7
93264	SE NW NE	-101.151549	39.087908	LEO by Hand	Mingo Coop Grain Co.	CONSTRUCTED	MW 8
93263	SE NW NE	-101.152581	39.087737	LEO by Hand	Mingo Coop Grain Co.	CONSTRUCTED	MW 9
376353	SE NW NE	-101.152581	39.087737	LEO by Hand	Cooperative Agricultural Services, Inc.	PLUGGED	MW 9