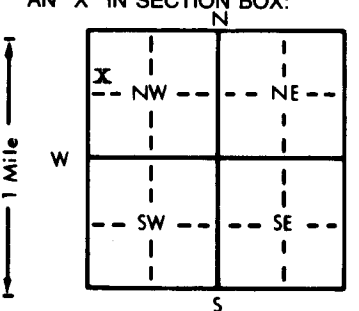


Date

1 LOCATION OF WATER WELL: Fraction SW 1/4 NW 1/4 NW 1/4 Section Number 2 Township Number T 11 S Range Number R 38 E/W

Distance and direction from nearest town or city street address of well if located within city?
14 south 1 east of Edson

2 WATER WELL OWNER: Sweet Ranch Properties, Inc.
 RR#, St. Address, Box # : Rt. 2 Board of Agriculture, Division of Water Resources
 City, State, ZIP Code : wallace, Kansas 67761 Application Number:

3 LOCATE WELL'S LOCATION WITH AN "X" IN SECTION BOX:  DEPTH OF COMPLETED WELL... 150 ft. ELEVATION:ft.
 Depth(s) Groundwater Encountered 1.ft. 2.ft. 3.ft.
 WELL'S STATIC WATER LEVEL ... 90 ft. below land surface measured on mo/day/yr 9-21-84
 Pump test data: Well water wasft. after hours pumping gpm
 Est. Yield gpm: Well water was not tested after hours pumping gpm
 Bore Hole Diameter..... 8 in. to 1.50 ft., and in. to ft.
 WELL WATER TO BE USED AS: 5 Public water supply 8 Air conditioning 11 Injection well
1 Domestic 3 Feedlot 6 Oil field water supply 9 Dewatering 12 Other (Specify below)
2 Irrigation 4 Industrial 7 Lawn and garden only 10 Observation well
 Was a chemical/bacteriological sample submitted to Department? Yes.....No...X.....; If yes, mo/day/yr sample was submitted
 Water Well Disinfected? Yes X No

5 TYPE OF BLANK CASING USED: 5 Wrought iron 8 Concrete tile CASING JOINTS: Glued X Clamped
 1 Steel 3 RMP (SR) 6 Asbestos-Cement 9 Other (specify below) Welded
 2 PVC 4 ABS 7 Fiberglass Threaded.....
 Blank casing diameter 5 in. to 1.30 ft., Dia in. to ft., Dia in. to ft.
 Casing height above land surface..... 1.0 in., weight 1.0/1.0 lbs./ft. Wall thickness or gauge No. 1/4
 TYPE OF SCREEN OR PERFORATION MATERIAL: 7 PVC 10 Asbestos-cement
 1 Steel 3 Stainless steel 5 Fiberglass 8 RMP (SR) 11 Other (specify)
 2 Brass 4 Galvanized steel 6 Concrete tile 9 ABS 12 None used (open hole)
 SCREEN OR PERFORATION OPENINGS ARE: 5 Gauzed wrapped 8 Saw cut 11 None (open hole)
 1 Continuous slot 3 Mill slot 6 Wire wrapped 9 Drilled holes
 2 Louvered shutter 4 Key punched 7 Torch cut 10 Other (specify)
 SCREEN-PERFORATED INTERVALS: From... 1.30 ft. to 1.50 ft., From ft. to ft.
 From ft. to ft., From ft. to ft.
 GRAVEL PACK INTERVALS: From... 1.0 ft. to 1.50 ft., From ft. to ft.
 From ft. to ft., From ft. to ft.

6 GROUT MATERIAL: 1 Neat cement 2 Cement grout 3 Bentonite 4 Other
 Grout Intervals: From..... 4 ft. to 1.0 ft., From ft. to ft., From ft. to ft.
 What is the nearest source of possible contamination:
 1 Septic tank 4 Lateral lines 7 Pit privy 10 Livestock pens 14 Abandoned water well
 2 Sewer lines 5 Cess pool 8 Sewage lagoon 11 Fuel storage 15 Oil well/Gas well
 3 Watertight sewer lines 6 Seepage pit 9 Feedyard 12 Fertilizer storage 16 Other (specify below)
 Direction from well? How many feet? in pasture for new home

FROM	TO	LITHOLOGIC LOG	FROM	TO	LITHOLOGIC LOG
1	10	top soil			
10	27	sand and clay strips			
27	47	sand rock and sand strips			
47	78	sandy clay and sand rock strips			
78	147	sand and sand rock strips			
147	150	oker and shale			

7 CONTRACTOR'S OR LANDOWNER'S CERTIFICATION: This water well was (1) constructed, (2) reconstructed, or (3) plugged under my jurisdiction and was completed on (mo/day/year) 9-21-84 and this record is true to the best of my knowledge and belief. Kansas Water Well Contractor's License No. 1.39 This Water Well Record was completed on (mo/day/yr) 7-2-85 under the business name of Bartell Drilling by (signature) Jayce Bartell

INSTRUCTIONS: Use typewriter or ball point pen, PLEASE PRESS FIRMLY and PRINT clearly. Please fill in blanks, underline or circle the correct answers. Send top three copies to Kansas Department of Health and Environment, Division of Environment, Environmental Geology Section, Topeka, KS 66620. Send one to WATER WELL OWNER and retain one for your records.

OFFICE USE ONLY
T
R
EW
SEC.
1/4
1/4
1/4