

Sent 2-21-77

# HARRIS DRAW WEST

USE TYPEWRITER OR BALL POINT PEN-PRESS FIRMLY, PRINT CLEARLY.


WATER WELL RECORD  
KSA 82a-1201-1215

Kansas Department of Health and Environment-Division of Environment  
(Water well Contractors)  
Topeka, Kansas 66620

DDD

1. Location of well: County: <b>Wallace</b>	Fraction: <b>SE 1/4 SE 1/4 SE 1/4</b>	Section number: <b>#6</b>	Township number: <b>T 11 S R 39</b>	Range number: <b>E/W</b>
--	---------------------------------------	---------------------------	-------------------------------------	--------------------------

2. Distance and direction from nearest town or city: <b>From Sharon Springs 15 miles North &amp; 3 1/2 miles East</b>	3. Owner of well: <b>Bellamy Brothers</b>
Street address of well location if in city:	R.R. or street: <b>P.O. Box 342</b>
	City, state, zip code: <b>Colby, Kansas 67701</b>

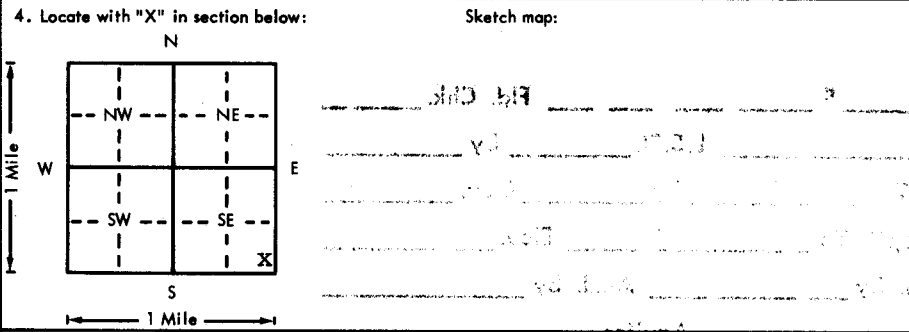

6. Bore hole dia. <b>28</b> in. Completion date: <b>10-30-75</b>
Well depth <b>206</b> ft.
7. Cable tool: <input checked="" type="checkbox"/> Rotary <input type="checkbox"/> Driven <input type="checkbox"/> Dug
<input type="checkbox"/> Hollow tool <input type="checkbox"/> Jetted <input type="checkbox"/> Bored <input checked="" type="checkbox"/> Reverse rotary
8. Use: <input type="checkbox"/> Domestic <input type="checkbox"/> Public supply <input type="checkbox"/> Industry
<input checked="" type="checkbox"/> Irrigation <input type="checkbox"/> Air conditioning <input type="checkbox"/> Stock
<input type="checkbox"/> Lawn <input type="checkbox"/> Oil field water <input type="checkbox"/> Other
9. Casing: Material <b>Steel</b> Height: Above or below
Threaded <input type="checkbox"/> Welded <input checked="" type="checkbox"/> Surface <b>12</b> in.
RMP: <input type="checkbox"/> PVC Weight <b>188</b> lbs./ft.
Dia. <b>16</b> in. to <b>136</b> ft. depth Wall Thickness: inches or
Dia. <b>16</b> in. to <b>136</b> ft. depth gage No. <b>#7</b>

5. Type and color of material	From	To
Sandy clay	0	28
Sandstone & sandy clay	28	36
Clay	36	75
Medium to coarse sand & gravel (very loose)	75	101
Sand & gravel	101	104
Clay with gravel streaks	104	109
Medium to coarse sand & gravel (very loose)	109	133
Sand stone	133	137
Sand & gravel (very loose)	137	158
Clay	158	160
Sand stone	160	161
Clay with small gravel streaks	161	199
Sand & gravel	199	204
Ochre	204	206
Shale	206	---

10. Screen Manufacturer's name: <b>W. A. Brown</b>
Type <b>perforated</b> Dia. <b>16"</b>
Slot/gauze <b>10%</b> Length <b>60'</b>
Set between <b>136</b> ft. and <b>196</b> ft.
<b>10' of cook</b> ft. and <b>206</b> ft.
Gravel pack? <b>yes</b> Size range of material <b>1/2 x 5/8</b>
11. Static water level: <b>90</b> ft. below land surface Date <b>11-1-75</b>
12. Pumping level below land surfaces: <b>139</b> ft. after <b>2</b> hrs. pumping <b>291</b> g.p.m.
ft. after _____ hrs. pumping _____ g.p.m.
Estimated maximum yield <b>300</b> g.p.m.
13. Water sample submitted: _____ mo./day/yr.
Yes <input checked="" type="checkbox"/> No <input type="checkbox"/> Date _____
14. Well head completion: <b>12</b> inches above grade
<input type="checkbox"/> Pitless adapter
15. Well grouted? <b>yes</b>
With: <input type="checkbox"/> Neat cement <input checked="" type="checkbox"/> Bentonite <input type="checkbox"/> Concrete
Depth: From <b>0</b> ft. to <b>10</b> ft.
16. Nearest source of possible contamination: <b>farm</b> MKC
ft. <b>5000</b> Direction <b>west</b> Type <b>farm</b>
Well disinfected upon completion? <input type="checkbox"/> Yes <input checked="" type="checkbox"/> No
17. Pump: <input checked="" type="checkbox"/> Not installed
Manufacturer's name _____
Model number _____ HP _____ Volts _____
Length of drop pipe _____ ft. capacity _____ g.p.m.
Type: _____
<input type="checkbox"/> Submersible <input type="checkbox"/> Turbine
<input type="checkbox"/> Jet <input type="checkbox"/> Reciprocating
<input type="checkbox"/> Centrifugal <input type="checkbox"/> Other

18. Elevation: _____	19. Remarks: <b>3625 (TOPO)</b>
Topography: _____	
<input type="checkbox"/> Hill	
<input type="checkbox"/> Slope	
<input checked="" type="checkbox"/> Upland	
<input type="checkbox"/> Valley	

20. Water well contractor's certification: This well was drilled under my jurisdiction and this report is true to the best of my knowledge and belief.
<b>Western Well &amp; Pump, Inc 245</b>
Business name: _____ License No. _____
P.O. Box <b>852</b> Colby, Ks
Address: _____
Signed: <b>Roy F. Senas</b> Date <b>11-2</b>
Authorized representative

11-2-75  
MKC  
320  
SE  
1/4  
1/4  
1/4