


1 LOCATION OF WATER WELL: County: Wallace Fraction: NE 1/4 NE 1/4 SW 1/4 Section Number: 14 Township Number: T 11 N R 09 E Range Number: 39 E

Distance and direction from nearest town or city street address of well if located within city? 13 N 1/2 W of Wallace

2 WATER WELL OWNER: Brookover Gattie Co. RR#, St. Address, Box #: Scott, City, Ks. City, State, ZIP Code: 67871 Board of Agriculture, Division of Water Resources Application Number:

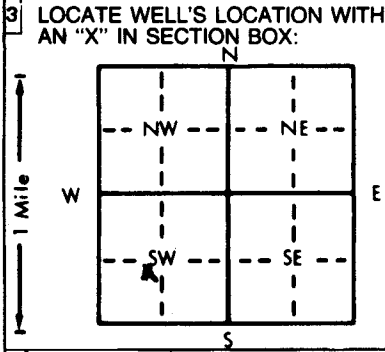

4 DEPTH OF COMPLETED WELL: 21 ft. ELEVATION: Depth(s) Groundwater Encountered 1. 8 ft. 2. ft. 3. ft. WELL'S STATIC WATER LEVEL 8 ft. below land surface measured on mo/day/yr Pump test data: Well water was ft. after hours pumping gpm Est. Yield 20 gpm: Well water was ft. after hours pumping gpm Bore Hole Diameter: 9 in. to 21 in. to ft. WELL WATER TO BE USED AS: 5 Public water supply 8 Air conditioning 11 Injection well 1 Domestic 3 Feedlot 6 Oil field water supply 9 Dewatering 12 Other (Specify below) 2 Irrigation 4 Industrial 7 Lawn and garden only 10 Monitoring well Stock Was a chemical/bacteriological sample submitted to Department? Yes No X; If yes, mo/day/yr sample was submitted Water Well Disinfected? Yes X No

5 TYPE OF BLANK CASING USED: 1 Steel 3 RMP (SR) 5 Wrought iron 8 Concrete tile CASING JOINTS: Glued X Clamped Welded Threaded 2 PVC 4 ABS 6 Asbestos-Cement 9 Other (specify below) Blank casing diameter 5 in. to 8 ft., Dia. in. to ft., Dia. in. to ft. Casing height above land surface 12 in., weight 250 lbs./ft. Wall thickness or gauge No. 250 TYPE OF SCREEN OR PERFORATION MATERIAL: 1 Steel 3 Stainless steel 5 Fiberglass 8 RMP (SR) 10 Asbestos-cement 2 Brass 4 Galvanized steel 6 Concrete tile 9 ABS 12 None used (open hole) SCREEN OR PERFORATION OPENINGS ARE: 1 Continuous slot 3 Mill slot 5 Gauzed wrapped 8 Saw cut 11 None (open hole) 2 Louvered shutter 4 Key punched 6 Wire wrapped 9 Drilled holes 7 Torch cut 10 Other (specify) SCREEN-PERFORATED INTERVALS: From 8 ft. to 21 ft., From ft. to ft. GRAVEL PACK INTERVALS: From 8 ft. to 21 ft., From ft. to ft.

6 GROUT MATERIAL: 1 Neat cement 2 Cement grout 3 Bentonite 4 Other Grout Intervals: From 0 ft. to 8 ft., From ft. to ft., From ft. to ft. What is the nearest source of possible contamination: 1 Septic tank 4 Lateral lines 7 Pit privy 10 Livestock pens 14 Abandoned water well 2 Sewer lines 5 Cess pool 8 Sewage lagoon 11 Fuel storage 15 Oil well/Gas well 3 Watertight sewer lines 6 Seepage pit 9 Feedyard 12 Fertilizer storage 16 Other (specify below) DRAW 13 Insecticide storage Direction from well? WEST How many feet? 100

FROM	TO	LITHOLOGIC LOG	FROM	TO	PLUGGING INTERVALS
0	11	Top soil			
11	20	DRAGEL			
20	21	SHALE			

7 CONTRACTOR'S OR LANDOWNER'S CERTIFICATION: This water well was 1 constructed, (2) reconstructed, or (3) plugged under my jurisdiction and was completed on (mo/day/year) 6-15-93 and this record is true to the best of my knowledge and belief. Kansas Water Well Contractor's License No. 376 This Water Well Record was completed on (mo/day/year) 7-10-93 under the business name of B&B Drilling by (signature) Joseph Beckmons

INSTRUCTIONS: Use typewriter or ball point pen. PLEASE PRESS FIRMLY and PRINT clearly. Please fill in blanks, underline or circle the correct answers. Send top three copies to Kansas Department of Health and Environment, Bureau of Water, Topeka, Kansas 66620-0001. Telephone: 913-296-5545. Send one to WATER WELL OWNER and retain one for your records.