

USE TYPEWRITER OR BALL POINT PEN-PRESS FIRMLY, PRINT CLEARLY.

Topo shows A B D


WATER WELL RECORD
KSA 82a-1201-1215

Kansas Department of Health and Environment-Division of Environment (Water well Contractors) Topeka, Kansas 66620

BDA Hand thief Draw NE

1. Location of well: County WALLACE Fraction NE 1/4 SE 1/4 NW 1/4 Section number 4 Township number T 11 S R 40 NW

2. Distance and direction from nearest town or city: Goodland
Street address of well location if in city: 145 2 W 1/2 S
3. Owner of well: LEE PARKER
R.R. or street: RR 2
City, state, zip code: Goodland Kansas 67735

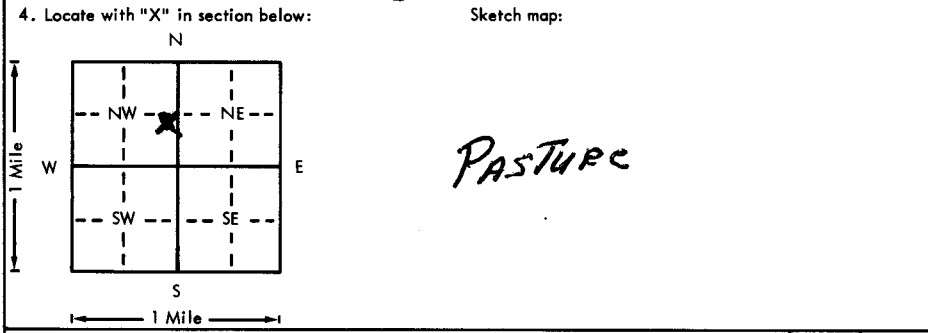

6. Bore hole dia. 8 in. Completion date 8-19-77
Well depth 38 1/2 ft.
7. Cable tool Rotary Driven Dug
 Hollow rod Jetted Bored Reverse rotary
8. Use: Domestic Public supply Industry
 Irrigation Air conditioning Stock
 Lawn Oil field water Other
9. Casing: Material Plastic Height: Above or below
Threaded Welded Surface 12 in.
RMP PVC Weight lbs./ft.
Dia. 4 in. to 2 1/2 in. depth Wall Thickness: inches or
Dia. in. to ft. depth gage No. 237

5. Type and color of material

	From	To
<u>FINE SAND, M GRAVEL</u>	<u>19</u>	<u>22</u>
<u>CLAY, M GRAVEL</u>	<u>22</u>	<u>25</u>
<u>M GRAVEL</u>	<u>25</u>	<u>32</u>
<u>DRBC</u>	<u>32</u>	<u>38 1/2</u>
<u>BROCK 32'</u>		

10. Screen: Manufacturer's name Jess + Lowell
Type LOUVER Dia. 5
Slot/gauze 1/8 258 Length 16
Set between 22 1/2 ft. and 38 1/2 ft.
ft. and ft.
Gravel pack? YES Size range of material 1/8
11. Static water level: mo./day/yr.
20 ft. below land surface Date 8-4-77
12. Pumping level below land surfaces:
35 ft. after 2 hrs. pumping 15 g.p.m.
 ft. after hrs. pumping g.p.m.
Estimated maximum yield 18 g.p.m.
13. Water sample submitted: mo./day/yr.
Yes No Date
14. Well head completion:
 Pitless adapter 12 inches above grade
15. Well grouted? YES
With: Neat cement Bentonite Concrete
Depth: From 5 ft. to 15 ft.
16. Nearest source of possible contamination: PASTURE
ft. Direction Type PASTURE
Well disinfected upon completion? Yes No
17. Pump: Not installed
Manufacturer's name Red Jacket
Model number 9 BC HP 1/2 Volts 230
Length of drop pipe 36 ft. capacity 10 g.p.m.
Type:
 Submersible Turbine
 Jet Reciprocating
 Centrifugal Other

18. Elevation: Topography: Hill Slope Upland Valley

19. Remarks: E Lev 3635 Topo 3635 3615

20. Water well contractor's certification:
This well was drilled under my jurisdiction and this report is true to the best of my knowledge and belief.
Business name J & H Pulling Co Inc 166 License No. 166
Address Goodland Kansas
Signed Bill Clifford Date 8-23-77
Authorized representative

T
R
Sec
4
NE SE NW
1/4 1/4