

USE TYPEWRITER OR BALL POINT PEN-PRESS FIRMLY, PRINT CLEARLY.


WATER WELL RECORD
KSA 82a-1201-1215

Kansas Department of Health and Environment-Division of Environment (Water well Contractors) Topeka, Kansas 66620

BBB Horsehead Draw SE

1. Location of well:	County Wallace	Fraction NW 1/4 NW 1/4 NW 1/4	Section number 20	Township number T 11 S	Range number R 40	E 1/4
----------------------	-------------------	----------------------------------	----------------------	---------------------------	----------------------	-------

2. Distance and direction from nearest town or city: Street address of well location if in city: 16 M. NW of Sharon Springs, Kansas	3. Owner of well: Vernon A. Vincent P.O. or street: Box 65 City, state, zip code: Wallace, Kansas 67761
---	---

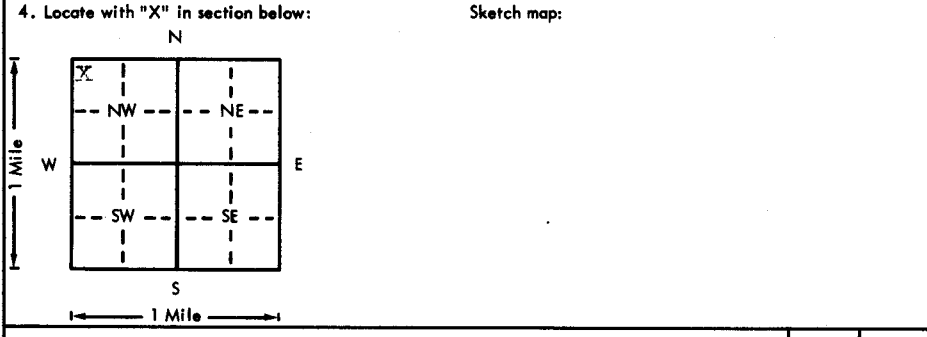

6. Bore hole dia. 8 in. Completion date _____
Well depth 40 ft. 1-6-87

7. Cable tool Rotary Driven Dug
 Hollow rod Jetted Bored Reverse rotary

8. Use: Domestic Public supply Industry
 Irrigation Air conditioning Stock
 Lawn Oil field water Other

9. Casing: Material dist Height: Above or below
Threaded Welded Surface 15 in.
RMP PVC Weight _____ lbs./ft.
Dia. 5 in. to 40 ft. depth Wall Thickness: inches or
Dia. _____ in. to _____ ft. depth Gauge No. 111

5. Type and color of material	From	To
Top Soil	0	10
Sand Clay	10	17
Sand and Sand Rock Strips	17	40
<u>ROCK ?</u>		

(Use a second sheet if needed)

10. Screen: Manufacturer's name J and L
Type RMP Dia. 5"
Slot/gauze 1/32" Length 10'
Set between 30 ft. and 40 ft.
_____ ft. and _____ ft.
Gravel pack? yes Size range of material 1/8"

11. Static water level: _____ mo./day/yr.
20 ft. below land surface Date _____

12. Pumping level below land surfaces:
_____ ft. after NA hrs. pumping _____ g.p.m.
_____ ft. after _____ hrs. pumping _____ g.p.m.
Estimated maximum yield _____ g.p.m.

13. Water sample submitted: _____ mo./day/yr.
Yes No Date _____

14. Well head completion:
yes Pitless adapter 20 inches above grade

15. Well grouted?
With: Neat cement Bentonite Concrete
Depth: From 1 ft. to 15 ft.

16. Nearest source of possible contamination:
ft. _____ Direction none Type _____
Well disinfected upon completion? Yes No

17. Pump: _____ Not installed
Manufacturer's name Red Jacket
Model number 11cc HP 1 1/2 Volts 230
Length of drop pipe 35 ft. capacity 18 g.p.m.
Type:
 Submersible Turbine
 Jet Reciprocating
 Centrifugal Other

18. Elevation: _____

19. Remarks: Elev 9630 Topo from 3630 / 20 / 3610

Topography:
 Hill
 Slope
 Upland
 Valley

20. Water well contractor's certification:
This well was drilled under my jurisdiction and this report is true to the best of my knowledge and belief.
Bartell Drilling 139
Business name _____ License No. _____
Address Winona, Kansas 67764
Signed Jay Bartell Date 4/77
Authorized representative

T
R
40
20
1/4
1/4
1/4
1/4