


GOODSCANIS 3SE

T R EW sec 1/4 1/4 1/4 No.


WATER WELL RECORD  
KSA 82a-1201-1215

Kansas State Dept. Of Health  
(Water Well Contractors)  
Forbes-Bldg. 740  
Topeka, Kansas 66620

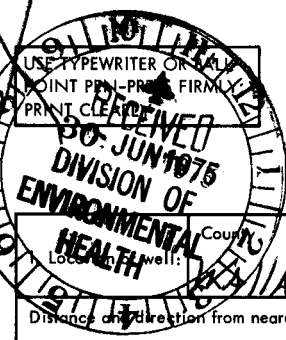

County: Wichita Township name: Morton SE 1/4 Fraction: 1/4 Section number: 10 Town number: 11 Range number: 41

Distance and direction from nearest town or city: 1 3/4 N 6 W IN 3 Owner of well: J.O. MATHER  
Street address of well location if in city: of SHARON, Spring Address: SHARON SPRING, KANS.

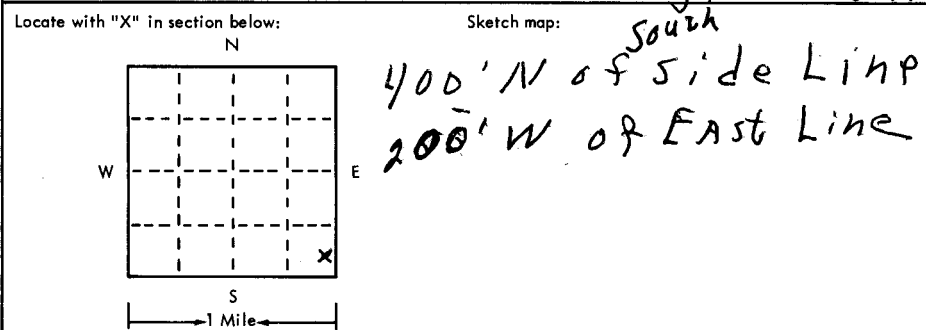

4 Well depth: 151 ft. Date of completion: 5-12-72  
Well diameter: 8 in. 5-12-75

5  Cable tool  Rotary  Driven  Dug  
 Hollow rod  Jetted  Bored  Reverse rotary

6 Use:  Domestic  Public supply  Industry  
 Irrigation  Air conditioning  Commercial  
 Test well

7 Casing: Material P Height: above/below  
Threaded  Welded  Surface      in.  
Diam.      Weight      lbs./ft.       
0 in. to 131 ft. depth! Drive shoe?  Yes  No  
17 in. to 151 ft. depth!

2	Type and color of material	From	To
	<u>Soil + Clay + Sand</u>	<u>0</u>	<u>31</u>
	<u>Clay + Sand</u>	<u>31</u>	<u>55</u>
	<u>Sand fine Bed</u>	<u>55</u>	<u>79</u>
	<u>Sand fine Bed + Clay + shell</u>	<u>79</u>	<u>105</u>
	<u>Sand fine to med</u>	<u>105</u>	<u>120</u>
	<u>Sand fine with Clay + shell</u>	<u>120</u>	<u>128</u>
	<u>Sand fine to med</u>	<u>128</u>	<u>140</u>
	<u>Sand fine + Clay + shell</u>	<u>140</u>	<u>148</u>
	<u>yellow clay + Blue shale</u>	<u>148</u>	<u>151</u>
	<u>13 ROCK 148'</u>		

8 Screen: Manufacturer: J+L  
Type: PLASTIC Dia. 5'  
Slot/gauze: 5/16 Length: 2"  
Set between 131 ft. and 151 ft.  
Fittings: PLASTIC  
Gravel pack  Yes  No Size range of material: 3/4

9 Static water level: 59 ft. below land surface Date: 5-12-75

10 Pumping level below land surfaces:  
     ft. after      hrs. pumping      g.p.m.  
     ft. after      hrs. pumping      g.p.m.  
Estimated maximum yield: 50 g.p.m. Plus

11 Water sample submitted:  
 Yes  No Date     

12 Well head completion:  
 Pitless adapter  Inches above grade

13 Well grouted?  Yes  No  
 Neat cement  Bentonite  SURFACE  
Depth: From 0 ft. to 56 ft.

14 Nearest source of possible contamination:  
ft. 60 Direction N Type BYALL  
Well disinfected upon completion?  Yes  No

15 Pump:  Not installed  
Manufacturer's name: Goulds  
Model number      HP 1HP Volts 230  
Length of drop pipe      ft. capacity      g.m.p.  
Type:  
 Submersible  Turbine  
 Jet  Reciprocating  
 Centrifugal  Other

16 Remarks: elevation 3762 (TOPO)

Topography:  
 Hill  
 Slope  
 Upland  
 Valley

17 Water well contractor's certification:  
This well was drilled under my jurisdiction and this report is true to the best of my knowledge and belief.  
Billy Husband 195  
Business name BOYD WESMAN KANS License No.       
Address       
Signed Billy Husband Date 10-24-75  
Authorized representative