

## CORRECTION(S) TO WATER WELL RECORD (WWC-5)

(to rectify lacking or incorrect information)

Location listed as:

Section-Township-Range: 3-11 S-42 WFraction (  $\frac{1}{4}$   $\frac{1}{4}$   $\frac{1}{4}$ ): CenterCounty: Wallace

Location changed to:

3-11 S-42 WC SWOther changes: Initial statements: 14 E - 14 S of Goodland.Sherman County.Changed to: From Goodland: 14 mi. W., 15 mi. S.Wallace County.

Comments: \_\_\_\_\_

verification method: Written & legal descriptions, position onplat map, and county ownership map.initials: DRP date: 6/14/2007

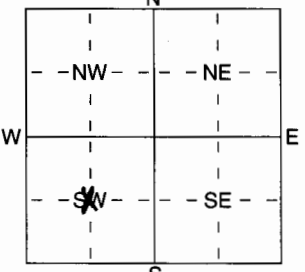
submitted by: Kansas Geological Survey, Data Resources Library, 1930 Constant Ave., Lawrence, KS 66047-3726

to: Kansas Dept of Health &amp; Environment, Bureau of Water, 1000 SW Jackson, Suite 420, Topeka, KS 66612-1367.

1 LOCATION OF WATER WELL: Fraction Center Section Number 3 Township Number T 11 S Range Number R 42 EW  
 County: Sherman

Distance and direction from nearest town or city street address of well if located within city?  
14 E - 185 1/2 Seph Goodland

2 WATER WELL OWNER: Golden Wheat Ranch  
 RR#, St. Address, Box #: Box 330 Board of Agriculture, Division of Water Resources  
 City, State, ZIP Code: Goodland, KS 677.35 Application Number:

3 LOCATE WELL'S LOCATION WITH AN "X" IN SECTION BOX:  
  
 4 DEPTH OF COMPLETED WELL: 200 ft. ELEVATION:  
 Depth(s) Groundwater Encountered: 1 150 ft. 2 ..... ft. 3 ..... ft.  
 WELL'S STATIC WATER LEVEL: 150 ft. below land surface measured on mo/day/yr 5-4-07  
 Pump test data: Well water was ..... ft. after ..... hours pumping ..... gpm  
 Est. Yield: 15 gpm: Well water was ..... ft. after ..... hours pumping ..... gpm  
 WELL WATER TO BE USED AS:  
 Domestic 3 Feedlot 5 Public water supply 8 Air conditioning 11 Injection well  
 2 Irrigation 4 Industrial 6 Oil field water supply 9 Dewatering 12 Other (Specify below)  
 7 Domestic (lawn & garden) 10 Monitoring well  
 Was a chemical/bacteriological sample submitted to Department? Yes  No   
 Water Well Disinfected? Yes  No

5 TYPE OF BLANK CASING USED:  
 1 Steel 3 RMP (SR) 5 Wrought iron 8 Concrete tile CASING JOINTS:  Glued ..... Clamped .....  
 2 Brass 4 Galvanized Steel 6 Asbestos-Cement 9 Other (specify below)  Welded .....  
 PVC 4 ABS 7 Fiberglass ..... Threaded .....  
 Blank casing diameter: 5 in. to 180 ft. Dia ..... in. to ..... ft. Dia ..... in. to ..... ft.  
 Casing height above land surface: 12 in., weight: 205 lbs./ft. Wall thickness or gauge No. SDR21  
 TYPE OF SCREEN OR PERFORATION MATERIAL:  
 1 Steel 3 Stainless Steel 5 Fiberglass 8 RMP (SR) 10 Asbestos-Cement  
 2 Brass 4 Galvanized Steel 6 Concrete tile 9 ABS 11 Other (Specify) .....  
 12 None used (open hole)  
 SCREEN OR PERFORATION OPENINGS ARE:  
 1 Continuous slot 3 Mill slot 5 Gauzed wrapped 8  Saw cut 11 None (open hole)  
 2 Louvered shutter 4 Key punched 6 Wire wrapped 9 Drilled holes  
 7 Torch cut 10 Other (specify) ..... ft.  
 SCREEN-PERFORATED INTERVALS: From 180 ft. to 200 ft., From ..... ft. to ..... ft.  
 GRAVEL PACK INTERVALS: From ..... ft. to ..... ft., From ..... ft. to ..... ft.  
plc gravel

6 GROUT MATERIAL:  1 Neat cement 2 Cement grout 3 Bentonite 4 Other .....  
 Grout intervals: From 0 ft. to 200 ft., From ..... ft. to ..... ft., From ..... ft. to ..... ft.  
 What is the nearest source of possible contamination:  
 1 Septic tank 4 Lateral lines 7 Pit privy 10 Livestock pens 14 Abandoned water well  
 2 Sewer lines 5 Cess pool 8 Sewage lagoon 11 Fuel storage 15 Oil well/Gas well  
 3 Watertight sewer lines 6 Seepage pit 9 Feedyard 12 Fertilizer storage 16 Other (specify below)  
 13 Insecticide storage .....  
 Direction from well? None in View How many feet?

FROM	TO	LITHOLOGIC LOG	FROM	TO	PLUGGING INTERVALS
0	20	clay			
20	40	gravel + clay			
40	60	sandstone + gravel			
60	80	clay			
80	100	sand + clay			
100	120	gravel + sand			
120	140	sandstone + gravel			
140	180	gravel			
180	200	gravel			
200		shale			

7 CONTRACTOR'S OR LANDOWNER'S CERTIFICATION: This water well was  (1) constructed, (2) reconstructed, or (3) plugged under my jurisdiction and was completed on (mo/day/year) 5-4-07 and this record is true to the best of my knowledge and belief. Kansas Water Well Contractor's Licence No. 784 This Water Well Record was completed on (mo/day/yr) 5-15-07 under the business name of Schaal Drilling Co. by signature Richard Schaal