

Sent 6-16-77

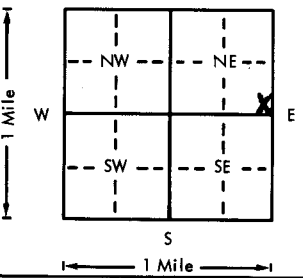
HUTSETHIEF DRAW

USE TYPEWRITER OR BALL POINT PEN-PRESS FIRMLY, PRINT CLEARLY.

WATER WELL RECORD
KSA 82a-1201-1215

Kansas Department of Health and Environment-Division of Environment
(Water well Contractors)
Topeka, Kansas 66620

ADD DBA

1. Location of well: County <u>WALLACE</u> Fraction <u>SE 1/4 SE 1/4 NE 1/4</u> Section number <u>4</u> Township number <u>T 11 S R 42 E 11</u> Range number <u>42</u>	
2. Distance and direction from nearest town or city: <u>KANARADO</u> Street address of well location if in city: <u>145 2E 1/2 S</u>	
3. Owner of well: <u>WAYNE KOEHLER</u> R.R. or street: <u>603 MAIN</u> City, state, zip code: <u>GOSSLAND KANSAS 67735</u>	
4. Locate with "X" in section below: Sketch map: 	
5. Type and color of material	
	From To
<u>GRAVEL SANDSTONE</u>	<u>40 52</u>
<u>SANDY CLAY</u>	<u>52 57</u>
<u>M GRAVEL TRACC CLAY</u>	<u>57 76</u>
<u>M GRAVEL</u>	<u>76 85</u>
<u>SANDY CLAY</u>	<u>85 93</u>
<u>M GRAVEL</u>	<u>93 95</u>
<u>Dchrc</u>	<u>95 106</u>
<u>BRCK 95'</u>	
6. Bore hole dia. <u>2 1/2</u> in. Completion date <u>6-6-76</u> Well depth <u>106</u> ft.	
7. <input type="checkbox"/> Cable tool <input type="checkbox"/> Rotary <input type="checkbox"/> Driven <input type="checkbox"/> Dug <input type="checkbox"/> Hollow rod <input type="checkbox"/> Jetted <input type="checkbox"/> Bored <input checked="" type="checkbox"/> Reverse rotary	
8. Use: <input type="checkbox"/> Domestic <input type="checkbox"/> Public supply <input type="checkbox"/> Industry <input checked="" type="checkbox"/> Irrigation <input type="checkbox"/> Air conditioning <input type="checkbox"/> Stock <input type="checkbox"/> Lawn <input type="checkbox"/> Oil field water <input type="checkbox"/> Other	
9. Casing: Material <u>Steel</u> Height: Above or below Threaded <input type="checkbox"/> Welded <input checked="" type="checkbox"/> Surface <u>12</u> in. RMP <input type="checkbox"/> PVC <input type="checkbox"/> Weight <u>36</u> lbs./ft. Dia. <u>16</u> in. to <u>66</u> ft. depth Wall Thickness: inches or Dia. <u> </u> in. to <u> </u> ft. depth gage No. <u>219</u>	
10. Screen: Manufacturer's name <u>W. H. BROWN</u> Type <u>Lower</u> Dia. <u>16</u> Slot/gauze <u>1/8 x .188</u> Length <u>40</u> Set between <u>66</u> ft. and <u>106</u> ft. Gravel pack? <u>Yes</u> Size range of material <u>1/4 x 3/8</u>	
11. Static water level: <u>42</u> ft. below land surface Date <u>9-29-76</u> mo./day/yr.	
12. Pumping level below land surfaces: <u>9.5</u> ft. after <u>4</u> hrs. pumping <u>350</u> g.p.m. <u> </u> ft. after <u> </u> hrs. pumping <u> </u> g.p.m. Estimated maximum yield <u>400</u> g.p.m.	
13. Water sample submitted: <u> </u> mo./day/yr. Yes <input checked="" type="checkbox"/> No <input type="checkbox"/> Date <u> </u>	
14. Well head completion: <input type="checkbox"/> Pitless adapter <u> </u> Inches above grade	
15. Well grouted? <u>Yes</u> With: <input type="checkbox"/> Neat cement <input type="checkbox"/> Bentonite <input checked="" type="checkbox"/> Concrete Depth: From <u>0</u> ft. to <u>10</u> ft.	
16. Nearest source of possible contamination: ft. <u> </u> Direction <u> </u> Type <u>None</u> Well disinfected upon completion? <input type="checkbox"/> Yes <input checked="" type="checkbox"/> No	
17. Pump: <input type="checkbox"/> Not installed Manufacturer's name <u>Westernland Rollon</u> Model number <u>6M</u> HP <u>40</u> Volts <u>480</u> Length of drop pipe <u>95</u> ft. capacity <u>350</u> g.p.m. Type: <input type="checkbox"/> Submersible <input checked="" type="checkbox"/> Turbine <input type="checkbox"/> Jet <input type="checkbox"/> Reciprocating <input type="checkbox"/> Centrifugal <input type="checkbox"/> Other	
18. Elevation: Topography: <u> </u> Hill <u> </u> Slope <u> </u> Upland <input checked="" type="checkbox"/> Valley	
19. Remarks: <u>3915 (TUPO)</u> <u>3895</u> <u>3853</u>	
20. Water well contractor's certification: This well was drilled under my jurisdiction and this report is true to the best of my knowledge and belief. <u>St H Dullery Co. Inc.</u> License No. <u> </u> Business name <u>Goosland Kansas</u> Address <u> </u> Signed <u>Bill Clifford</u> Date <u>6-7-77</u> Authorized representative	

L L 420 - 4 SE SE NE
1/4 1/4 1/4