


1 LOCATION OF WATER WELL: County: X WALLACE Fraction: X NW 1/4 NW 1/4 NE 1/4 Section Number: 4 Township Number: T 11 S Range Number: R 42 EW

Distance and direction from nearest town or city street address of well if located within city? X 1 MILE EAST, 12 SOUTH, 2 1/2 EAST OF KANORADO, KANSAS

2 WATER WELL OWNER: WAYNE KOEHLER RR#, St. Address, Box #: 58201 RD. E City, State, ZIP Code: BURLINGTON, Colo 80807 Board of Agriculture, Division of Water Resources Application Number:

3 LOCATE WELL'S LOCATION WITH AN "X" IN SECTION BOX:

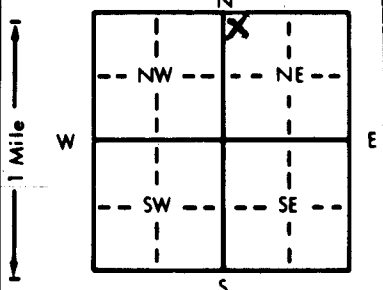

4 DEPTH OF COMPLETED WELL: X 48 ft. ELEVATION:

Depth(s) Groundwater Encountered: 1. ft. 2. ft. 3. ft. WELL'S STATIC WATER LEVEL: X DRY ft. below land surface measured on mo/day/yr Pump test data: Well water was ... ft. after ... hours pumping ... gpm Est. Yield ... gpm: Well water was ... ft. after ... hours pumping ... gpm Bore Hole Diameter ... in. to ... ft., and ... in. to ... ft. WELL WATER TO BE USED AS: 5 Public water supply 8 Air conditioning 11 Injection well 6 Oil field water supply 9 Dewatering 12 Other (Specify below) 2 Irrigation 4 Industrial 7 Lawn and garden only 10 Monitoring well Was a chemical/bacteriological sample submitted to Department? Yes ... No ...; If yes, mo/day/yr sample was submitted Water Well Disinfected? Yes No

5 TYPE OF BLANK CASING USED: 5 Wrought iron 8 Concrete tile CASING JOINTS: Glued Clamped

Blank casing diameter: X 5 in. to UNKNOWN ft., Dia. in. to ... ft., Dia. in. to ... ft. Casing height above land surface: X 12 in., weight ... lbs./ft. Wall thickness or gauge No.

TYPE OF SCREEN OR PERFORATION MATERIAL: UNKNOWN 7 PVC 10 Asbestos-cement 1 Steel 3 Stainless steel 5 Fiberglass 8 RMP (SR) 11 Other (specify) 2 Brass 4 Galvanized steel 6 Concrete tile 9 ABS 12 None used (open hole)

SCREEN OR PERFORATION OPENINGS ARE: UNKNOWN 5 Gauzed wrapped 8 Saw cut 11 None (open hole) 1 Continuous slot 3 Mill slot 6 Wire wrapped 9 Drilled holes 2 Louvered shutter 4 Key punched 7 Torch cut 10 Other (specify)

SCREEN-PERFORATED INTERVALS: UNKNOWN From ... ft. to ... ft., From ... ft. to ... ft. GRAVEL PACK INTERVALS: UNKNOWN From ... ft. to ... ft., From ... ft. to ... ft.

6 GROUT MATERIAL: X 1 Neat cement 2 Cement grout 3 Bentonite 4 Other Grout Intervals: From X 6 ft. to X 3 ft., From ... ft. to ... ft., From ... ft. to ... ft.

What is the nearest source of possible contamination: X 1 Septic tank 4 Lateral lines 7 Pit privy 10 Livestock pens 14 Abandoned water well 2 Sewer lines 5 Cess pool 8 Sewage lagoon 11 Fuel storage 15 Oil well/Gas well 3 Watertight sewer lines 6 Seepage pit 9 Feedyard 12 Fertilizer storage 16 Other (specify below) 13 Insecticide storage

Direction from well? X WEST How many feet? X 600

Table with columns: FROM, TO, LITHOLOGIC LOG, FROM, TO, PLUGGING INTERVALS. Data includes 48 x 6 CLAY, 6 x 3 Hole plug (BENTONITE), 3 x 0 Top soil, and X.

7 CONTRACTOR'S OR LANDOWNER'S CERTIFICATION: This water well was (1) constructed, (2) reconstructed, or (3) plugged under my jurisdiction and was completed on (mo/day/year) X 4-4-89 and this record is true to the best of my knowledge and belief. Kansas Water Well Contractor's License No. ... This Water Well Record was completed on (mo/day/yr) X 4-4-89 under the business name of ... by (signature) X Wayne Koehler