

HORSESHOE DRAW

USE TYPEWRITER OR BALL POINT PEN-PRESS FIRMLY, PRINT CLEARLY.

T R EW sec 1/4 1/4 1/4 No.


WATER WELL RECORD
KSA 82a-1201-1215

Kansas State Dept. Of Health
(Water Well Contractors)
Forbes-Bldg. 740
Topeka, Kansas 66620

ACB ACB

| | | | | | | |
|---------------------|--------------------------|--------------------------------------------|-----------------------------|-----------------------------|--------------------------|---------------------------|
| 1 Location of well: | County Wallace | Township name Morton SE 1/4 N.E. | Fraction 1/4 N.E. | Section number 16 | Town number 11 | Range number 42 |
|---------------------|--------------------------|--------------------------------------------|-----------------------------|-----------------------------|--------------------------|---------------------------|

| | |
|---|------------------------------------------------------------------------------|
| Distance and direction from nearest town or city: 17 miles North Street address of well location if in city: of Weskan, Kansas | 3 Owner of well: Dale Cloyd Address: Kanorado, Kansas |
|---|------------------------------------------------------------------------------|

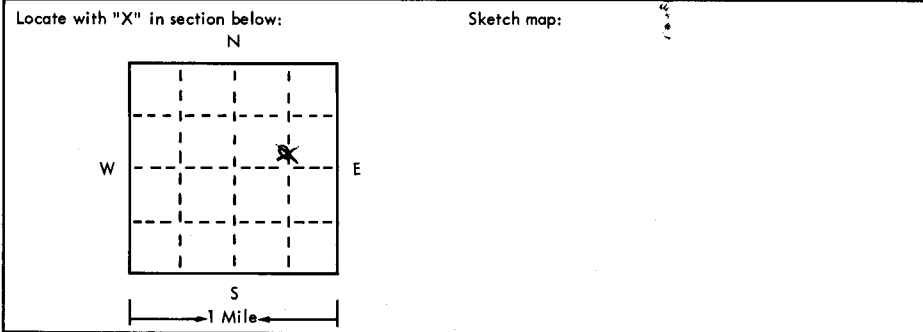

| |
|---|
| 4 Well depth: 192 ft. Date of completion 2-28-75 Well diameter 28 in. |
| 5 <input type="checkbox"/> Cable tool <input type="checkbox"/> Rotary <input type="checkbox"/> Driven <input type="checkbox"/> Dug <input type="checkbox"/> Hollow rod <input type="checkbox"/> Jetted <input type="checkbox"/> Bored <input checked="" type="checkbox"/> Reverse rotary |
| 6 Use: <input type="checkbox"/> Domestic <input type="checkbox"/> Public supply <input type="checkbox"/> Industry <input checked="" type="checkbox"/> Irrigation <input type="checkbox"/> Air conditioning <input type="checkbox"/> Commercial <input type="checkbox"/> Test well |
| 7 Casing: Material steel Height: above/below Threaded <input type="checkbox"/> Welded <input checked="" type="checkbox"/> Surface 12 in. Diam. 16 in. to 122 ft. depth Drive shoe? <input type="checkbox"/> Yes <input checked="" type="checkbox"/> No Weight 7 gauge/ft. |

| 2 Type and color of material | From | To |
|-----------------------------------------------------------|------|-----|
| Clay & sand streaks | 0 | 110 |
| Sandy clay | 110 | 118 |
| Cemented sand & sandy clay | 118 | 123 |
| Clay | 123 | 129 |
| Fine to coarse sand & fine gravel | 129 | 131 |
| Sandy clay & cemented sand | 131 | 136 |
| Fine to coarse sand & fine gravel | 136 | 144 |
| Cemented sand & sandy clay | 144 | 149 |
| Fine to coarse sand & fine gravel | 149 | 159 |
| Sandy clay | 159 | 161 |
| Fine to coarse sand & coarse sand & gravel | 161 | 171 |
| Sandy clay | 171 | 172 |
| Cemented sand | 172 | 173 |
| Fine to coarse sand & coarse gravel | 173 | 183 |
| Fine to coarse sand & fine gravel | 183 | 190 |
| Shale BROCK 190' (use a second sheet if needed) | 190 | 192 |

| |
|---|
| 8 Screen: Manufacturer W. A. Brown Type bridge Dia. 16" Slot/gauze 1/8 Length 2" Set between 122 ft. and 182 ft. Fittings: 10' of cook 182-192 Gravel pack <input checked="" type="checkbox"/> Yes <input type="checkbox"/> No Size range of material 1/2 5/8 |
| 9 Static water level: 118 ft. below land surface Date 3-1-75 |
| 10 Pumping level below land surfaces: 150 ft. after 2 hrs. pumping 725 g.p.m. ____ ft. after ____ hrs. pumping ____ g.p.m. Estimated maximum yield 800 g.p.m. |
| 11 Water sample submitted: <input type="checkbox"/> Yes <input checked="" type="checkbox"/> No Date ____ |
| 12 Well head completion: <input type="checkbox"/> Pitless adapter <input checked="" type="checkbox"/> 12 Inches above grade |
| 13 Well grouted? <input checked="" type="checkbox"/> Yes <input type="checkbox"/> No <input type="checkbox"/> Neat cement <input checked="" type="checkbox"/> Bentonite <input type="checkbox"/> & clay Depth: From 0 ft. to 10 ft. |
| 14 Nearest source of possible contamination: ft. 2 miles Direction West Type unknown Well disinfected upon completion? <input type="checkbox"/> Yes <input checked="" type="checkbox"/> No |
| 15 Pump: <input type="checkbox"/> Not installed Manufacturer's name Johnston Model number ____ HP 80 Volts ____ Length of drop pipe 180 ft. capacity 600 g.m.p. Type: <input type="checkbox"/> Submersible <input checked="" type="checkbox"/> Turbine <input type="checkbox"/> Jet <input type="checkbox"/> Reciprocating <input type="checkbox"/> Centrifugal <input type="checkbox"/> Other |

16 Remarks: elevation

Topography:
 Hill
 Slope
 Upland
 Valley

3950 (TUPO)
3950

3957
115
3839

17 Water well contractor's certification:
This well was drilled under my jurisdiction and this report is true to the best of my knowledge and belief.
Western Well & Pump Inc. 245
Business name
Address **Box 852, Colby, KS.** License No. ____
Signed **Roy F. Janney** Date **3-28-75**
Authorized representative