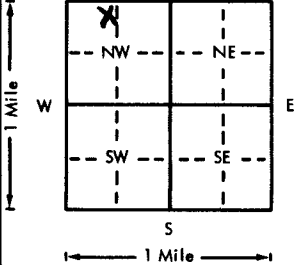


USE TYPEWRITER OR BALL POINT PEN-PRESS FIRMLY, PRINT CLEARLY.

WATER WELL RECORD
KSA 82a-1201-1215

Kansas Department of Health and Environment-Division of Environment
(Water well Contractors)
Topeka, Kansas 66620

1. Location of well:	County Ottawa	Fraction NE 1/4 NW 1/4 NW 1/4	Section number 33	Township number T 11 S R 5W E W	
2. Distance and direction from nearest town or city: Street address of well location if in city: 3 mi. N + 3/4 W, Tescott			3. Owner of well: Kenneth Green R.R. or street: Rt. 1 City, state, zip code: Tescott, Kans 67484		
4. Locate with "X" in section below: N W E S 1 Mile 1 Mile			Sketch map: 		
5. Type and color of material			6. Bore hole dia. 8 in. Completion date 11-12-75 Well depth 65 ft.		
			7. <input type="checkbox"/> Cable tool <input checked="" type="checkbox"/> Rotary <input type="checkbox"/> Driven <input type="checkbox"/> Dug <input type="checkbox"/> Hollow rod <input type="checkbox"/> Jetted <input type="checkbox"/> Bored <input type="checkbox"/> Reverse rotary		
			8. Use: <input checked="" type="checkbox"/> Domestic <input type="checkbox"/> Public supply <input type="checkbox"/> Industry <input type="checkbox"/> Irrigation <input type="checkbox"/> Air conditioning <input type="checkbox"/> Stock <input type="checkbox"/> Lawn <input type="checkbox"/> Oil field water <input type="checkbox"/> Other		
			9. Casing: Material RMP Height: Above or below Threaded <input type="checkbox"/> Welded <input type="checkbox"/> Surface 14 in. RMP <input type="checkbox"/> PVC <input type="checkbox"/> Weight <input type="checkbox"/> lbs./ft. Dia. 5 in. to 65 ft. depth Wall Thickness: inches or Dia. <input type="checkbox"/> in. to <input type="checkbox"/> ft. depth gage No. 250 MNC		
			10. Screen: Manufacturer's name Shap Type slotted Dia. 5" Slot/gauze 1/16" Length 3' Set between 62 ft. and 65 ft. <input type="checkbox"/> ft. and <input type="checkbox"/> ft. Gravel pack? <input checked="" type="checkbox"/> Size range of material 2.5 mm		
			11. Static water level: ma./day/yr. 26 ft. below land surface Date 11-12-75		
			12. Pumping level below land surfaces: 47 ft. after 1 hrs. pumping 10 g.p.m. <input type="checkbox"/> ft. after <input type="checkbox"/> hrs. pumping <input type="checkbox"/> g.p.m. Estimated maximum yield 10 g.p.m.		
			13. Water sample submitted: mo./day/yr. Yes <input checked="" type="checkbox"/> No <input type="checkbox"/> Date <input type="checkbox"/>		
			14. Well head completion: <input type="checkbox"/> Pitless adapter 14 Inches above grade		
			15. Well grouted? Yes MNC With: <input checked="" type="checkbox"/> Neat cement <input type="checkbox"/> Bentonite <input type="checkbox"/> Concrete Depth: From 7 ft. to 13 ft.		
			16. Nearest source of possible contamination: MNC ft. 205 Direction E Type Septic Well disinfected upon completion? <input checked="" type="checkbox"/> Yes <input type="checkbox"/> No		
			17. Pump: <input checked="" type="checkbox"/> Not installed Manufacturer's name <input type="checkbox"/> Model number <input type="checkbox"/> HP <input type="checkbox"/> Volts <input type="checkbox"/> Length of drop pipe <input type="checkbox"/> ft. capacity <input type="checkbox"/> g.p.m. Type: <input type="checkbox"/> Submersible <input type="checkbox"/> Turbine <input type="checkbox"/> Jet <input type="checkbox"/> Reciprocating <input type="checkbox"/> Centrifugal <input type="checkbox"/> Other		
			20. Water well contractor's certification: This well was drilled under my jurisdiction and this report is true to the best of my knowledge and belief. Redmond Drilling 126 Business name License No. Address Old & Salina Roads Signed O. J. Fant Date 12-30-75 Authorized representative		
18. Elevation: 1355	19. Remarks:				
Topography: <input type="checkbox"/> Hill <input checked="" type="checkbox"/> Slope <input type="checkbox"/> Upland <input type="checkbox"/> Valley					

T
R
E
S
E
C
T
I
O
N
11
S
R
5
W
E
W

Forward the white, blue and pink copies to the Department of Health and Environment

Form WWC-5