

WATER WELL RECORD

Form WWC-5


Division of Water Resources App. No.

Blank box for application number

1 LOCATION OF WATER WELL: County: Lincoln, Fraction: 1/4 NW 1/4 SW 1/4 NE 1/4, Section Number: 3-, Township No.: T 11 S, Range Number: R 7, E/W checkboxes

Street/Rural Address of Well Location; if unknown, distance & direction from nearest town or intersection: If at owner's address, check here [ ]. 1N of Lincoln, KS. Global Positioning System (GPS) information: Latitude, Longitude, Elevation, Datum, Collection Method

2 WATER WELL OWNER: Kirk and Susan Wollesen, RR#, Street Address, Box #: 205 S. 1st, City, State, ZIP Code: Lincoln, KS 67455. GPS unit, Digital Map/Photo, Topographic Map, Land Survey, Est. Accuracy checkboxes

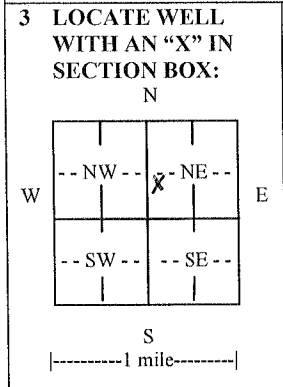

4 DEPTH OF COMPLETED WELL 65 ft. Depth(s) Groundwater Encountered (1) 35 ft. (2) ft. (3) ft. WELL'S STATIC WATER LEVEL 35 ft. below land surface measured on mo/day/yr. 06/29/12. Pump test data: Well water was ft. after hours pumping gpm. EST. YIELD 10 gpm. Well water was ft. after hours pumping gpm. Bore Hole Diameter in. to ft. and in. to ft. WELL WATER TO BE USED AS: Domestic, Feedlot, Oil field water supply, Dewatering, Other, Irrigation, Industrial, Domestic-lawn & garden, Monitoring well. Was a chemical/bacteriological sample submitted to Department? Yes/No. If yes, mo/day/yr sample was submitted. Water well disinfected? Yes/No

5 TYPE OF CASING USED: Steel, PVC, Other. CASING JOINTS: Glued, Clamped, Welded, Threaded. Casing diameter 5 in. to 45 ft., Diameter in. to ft., Diameter in. to ft. Casing height above land surface 12 in., Weight 2.8 lbs./ft., Wall thickness or gauge No. Sch. 40. TYPE OF SCREEN OR PERFORATION MATERIAL: Steel, Stainless Steel, PVC, Brass, Galvanized Steel, None used (open hole). SCREEN OR PERFORATION OPENINGS ARE: Continuous slot, Mill slot, Gauze wrapped, Torch cut, Drilled holes, None (open hole), Louvered shutter, Key punched, Wire wrapped, Saw cut, Other (specify). SCREEN-PERFORATED INTERVALS: From 45 ft. to 65 ft., From ft. to ft., From ft. to ft. GRAVEL PACK INTERVALS: From 23 ft. to 65 ft., From ft. to ft., From ft. to ft.

6 GROUT MATERIAL: Neat cement, Cement grout, Bentonite, Other. Grout Intervals: From 0 ft. to 23 ft., From ft. to ft., From ft. to ft. What is the nearest source of possible contamination: Septic tank, Lateral lines, Pit privy, Livestock pens, Insecticide storage, Sewer lines, Cesspool, Sewage lagoon, Fuel storage, Abandoned water well, Watertight sewer lines, Seepage pit, Feedyard, Fertilizer storage, Oil well/gas well, house. Direction from well South Southeast, Distance from well 75.

Table with columns: FROM, TO, LITHOLOGIC LOG, FROM, TO, LITHO. LOG (cont.) or PLUGGING INTERVALS. Rows: 0-2 top soil, 2-9 clay, 9-17 sand rock, 17-43 shale, 43-62 sand rock, 62-65 shale.

7 CONTRACTOR'S OR LANDOWNER'S CERTIFICATION: This water well was constructed, reconstructed, or plugged under my jurisdiction and was completed on (mo/day/year) 05/29/12 and this record is true to the best of my knowledge and belief. Kansas Water Well Contractor's License No. 186. This Water Well Record was completed on (mo/day/year) 06/11/12 under the business name of Kelly's Water Well Service, Inc. by (signature) Kelly's Water Well Service, Inc.

INSTRUCTIONS: Use typewriter or ball point pen. PLEASE PRESS FIRMLY and PRINT clearly. Please fill in blanks and check the correct answers. Send three copies (white, blue, pink) to Kansas Department of Health and Environment, Bureau of Water, Geology Section, 1000 SW Jackson St., Suite 420, Topeka, Kansas 66612-1367. Telephone 785-296-5524. Send one copy to WATER WELL OWNER and retain one for your records. Include fee of \$5.00 for each constructed well. Visit us at http://www.kdheks.gov/waterwell/index.html.