

Remed


WATER WELL PLUGGING RECORD Form WWC-5P KSA 82a-1212 ID NO.

MWI

I LOCATION OF WATER WELL: County: Lincoln Fraction NE 1/4 NE 1/4 SE 1/4 SE 1/4 Section Number 34 Township Number T 11 S Range Number 8 E X W

Street/Rural Address of Well Location; if unknown, distance & direction from nearest town or intersection: If at owner's address, check here 1324 N 170th Rd, Lincoln, KS Global Positioning Systems (GPS) information: Latitude: 39.04854 Longitude: 98.18907 Elevation: NA

2 WATER WELL OWNER: Walker Products Co. RR#, St. Address, Box #: PO Box 349 City, State ZIP Code: Lincoln, KS 67455

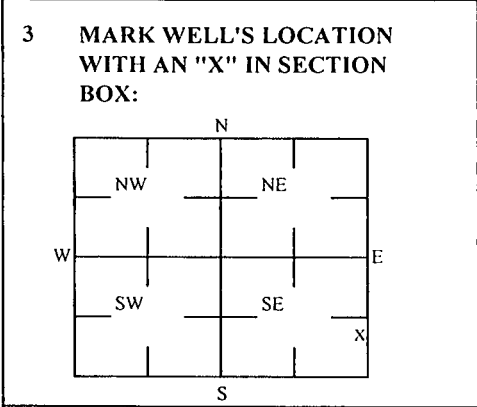

4 DEPTH OF WELL 48.3 ft. WELL'S STATIC WATER LEVEL NA ft. WELL WAS USED AS: Domestic, Irrigation, Feedlot, Industrial, Public Water Supply, Oil Field Water Supply, Domestic (Lawn & Garden), Air Conditioning, Dewatering, Monitoring, Injection Well, Other. Was a chemical/bacteriological sample submitted to Department? Yes No X

5 TYPE OF BLANK CASING USED: Steel, RMP (SR), Wrought, Fiberglass, Other (Specific below), PVC, ABS, Asbestos-Cement, Concrete Tile. Blank casing diameter 2 in. Was casing pulled? Yes X No If yes, how much 3'

6 GROUT PLUG MATERIAL: Neat cement, Cement grout, Bentonite X, Other X Soil: 0-0.5' Grout Plug Intervals: From 0.5 ft to 48.3 ft, From ft to ft, From ft to ft. What is the nearest source of possible contamination: Septic tank, Sewer lines, Watertight sewer lines, Lateral lines, Cess pool, Seepage pit, Pit privy, Sewage lagoon, Feed yard, Livestock pens, Fuel storage X, Fertilizer storage, Insecticide storage, Abandoned water well, Oil well/Gas well, Other (specify below)

Table with columns FROM, TO, PLUGGING MATERIALS. Rows: 0 to 0.5 Soil, 0.5 to 48.3 Bentonite. KDHE ID: Walker Products Co., Inc. U5-053-00111

7 CONTRACTOR'S OR LANDOWNER'S CERTIFICATION: This water well was plugged under my jurisdiction and was completed on (mo/day/year) 8/20-21/19 and this record is true to the best of my knowledge and belief. Kansas Water Contractor's License No. 757. This Water Well Record was completed on (mo/day/year) 9/4/2019 under the business name of Larsen & Associates, Inc. By (signature)

Send one white copy to Kansas Department of Health & Environment, Geology Section, 1000 SW Jackson Street, Ste. 420, Topeka, KS 66612-1367. Send one copy to WATER WELL OWNER and retain one for your records. Visit us at http://www.kdheks.gov/waterwell/index.html Telephone 785-296-5524.