

1 LOCATION OF WATER WELL:	Fraction	Section Number	Township Number	Range Number
County: <u>Lincoln</u>	<u>SE 1/4 NE 1/4 SW 1/4</u>	<u>22</u>	T <u>11</u> S	R <u>9</u> E <u>W</u>

Distance and direction from nearest town or city street address of well if located within city?

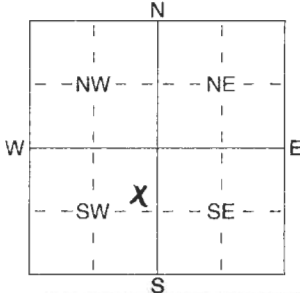
1.5 miles west and .75 miles south of Denmark, Ks.2 WATER WELL OWNER: M H W Enterprises, IncRR#, St. Address, Box # : 819 E. Rye DriveCity, State, ZIP Code : Sylvan Grove, Ks 67481

Board of Agriculture, Division of Water Resources

Application Number:

3 LOCATE WELL'S LOCATION WITH 4 DEPTH OF COMPLETED WELL 139 ft. ELEVATION:

AN "X" IN SECTION BOX:

Depth(s) Groundwater Encountered 1 ft. 2 ft. 3 ft.WELL'S STATIC WATER LEVEL 60 ft. below land surface measured on mo/day/yr 1/21/05

Pump test data: Well water was ft. after hours pumping gpm

Est. Yield 20 gpm: Well water was ft. after hours pumping gpm

WELL WATER TO BE USED AS:

1 Domestic	3 Feedlot	5 Public water supply	8 Air conditioning	11 Injection well
2 Irrigation	4 Industrial	6 Oil field water supply	9 Dewatering	12 Other (Specify below)
		7 Domestic (lawn & garden)	10 Monitoring well	<u>Livestock</u>

Was a chemical/bacteriological sample submitted to Department? Yes No X If yes, mo/day/yr sample was submitted

Water Well Disinfected? Yes No

5 TYPE OF BLANK CASING USED:

- 1 Steel
2 PVC
 3 RMP (SR)
 4 ABS

- 5 Wrought iron
 6 Asbestos-Cement
 7 Fiberglass

- 8 Concrete tile
 9 Other (specify below)

CASING JOINTS: Glued X Clamped
 Welded
 Threaded

Blank casing diameter 5 in. to 7.9 ft., Dia in. to ft., Dia in. to ft.Casing height above land surface 18 in., weight 140 lbs./ft. Wall thickness or gauge No.

TYPE OF SCREEN OR PERFORATION MATERIAL:

- 1 Steel
 2 Brass
 3 Stainless Steel
 4 Galvanized Steel

- 5 Fiberglass
 6 Concrete tile

- PVC
 8 RMP (SR)
 9 ABS
 10 Asbestos-Cement
 11 Other (Specify)
 12 None used (open hole)

SCREEN OR PERFORATION OPENINGS ARE:

- 1 Continuous slot
 2 Louvered shutter
3 Mill slot
 4 Key punched

- 5 Gauzed wrapped
 6 Wire wrapped
 7 Torch cut

- 8 Saw cut
 9 Drilled holes
 10 Other (specify)
 11 None (open hole)

SCREEN-PERFORATED INTERVALS: From 7.9 ft. to 139 ft., From ft. to ft.GRAVEL PACK INTERVALS: From 2.5 ft. to 140 ft., From ft. to ft.

From ft. to ft., From ft. to ft.

6 GROUT MATERIAL:

1 Neat cement

2 Cement grout

3 Bentonite

4 Other

Grout Intervals: From 0 ft. to 2.5 ft., From ft. to ft., From ft. to ft.

What is the nearest source of possible contamination:

- 1 Septic tank
 2 Sewer lines
 3 Watertight sewer lines
 4 Lateral lines
 5 Cess pool
 6 Seepage pit

- 7 Pit privy
 8 Sewage lagoon
 9 Feedyard

- 10 Livestock pens
 11 Fuel storage
 12 Fertilizer storage
 13 Insecticide storage
 14 Abandoned water well
 15 Oil well/Gas well
 16 Other (specify below)
Pasture

Direction from well?

How many feet?

FROM	TO	LITHOLOGIC LOG	FROM	TO	PLUGGING INTERVALS
0	16	Clay - brown			
16	24	Clay - yellow			
24	35	Clay - gray			
35	47	Clay - black			
47	70	Shale - gray			
70	85	Shale - red			
85	90	Shale - red with sandstone stringers			
90	115	Shale - gray with sandstone stringers			
115	128	Sandstone - white, medium			
128	140	Shale - gray with sandstone stringers			

7 CONTRACTOR'S OR LANDOWNER'S CERTIFICATION: This water well was (1) constructed, (2) reconstructed, or (3) plugged under my jurisdiction and was completed on (mo/day/year) 1/21/05 and this record is true to the best of my knowledge and belief. Kansas Water Well Contractor's Licence No 527 This Water Well Record was completed on (mo/day/yr) 1/22/05

under the business name of Geolore Incby (signature) Dan Hall