


Table with 4 columns: LOCATION OF WATER WELL, Fraction, Section Number, Township Number, Range Number. Includes County: Lincoln, SW 1/4 SW 1/4 SW 1/4, Section Number 36, Township Number T 11 S, Range Number R 9 E/W.

Distance and direction from nearest town or city street address of well if located within city? Lat. 39.04617, Long. 98.27966, K-18 Highway and N 120 Rd, Vesper

WATER WELL OWNER: Feldkamp Brothers, RR#, St. Address, Box #: P.O. Box 26, City, State, ZIP Code: Sylvan Grove, Kansas 67481, Board of Agriculture, Division of Water Resources, Application Number: Corrected

LOCATE WELL'S LOCATION WITH AN 'X' IN SECTION BOX:

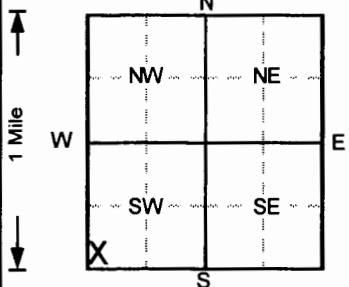

DEPTH OF COMPLETED WELL: 12.5 ft. ELEVATION: 1420.55. WELL'S STATIC WATER LEVEL, Pump test data, Est. Yield, Bore Hole Diameter, WELL WATER TO BE USED AS: 10 Monitoring well.

TYPE OF BLANK CASING USED: 2 PVC, 3 RMP (SR), 5 Wrought iron, 8 Concrete tile, CASING JOINTS: Threaded.

Blank casing diameter: 2 in. to 4 in., Dia. Casing height above land surface: -4.92 in., weight, lbs./ft. Wall thickness or gauge No. Sch. 40. TYPE OF SCREEN OR PERFORATION MATERIAL: 7 PVC, 10 Asbestos-cement.

SCREEN OR PERFORATION OPENINGS ARE: 3 Mill slot, 5 Gauzed wrapped, 8 Saw cut, 11 None (open hole).

SCREEN-PERFORATED INTERVALS: From 4 ft to 12.5 ft. GRAVEL PACK INTERVALS: From 3 ft to 12.5 ft.

6 GROUT MATERIAL: 3 Bentonite, 4 Other Concrete. Grout Intervals: From 0 ft to 1 ft, From 1 ft to 3 ft.

What is the nearest source of possible contamination: 10 Livestock pens, 14 Abandoned water well, 15 Oil well/Gas well, 16 Other (specify below).

Table with columns: FROM, TO, LITHOLOGIC LOG, FROM, TO, PLUGGING INTERVALS. Includes lithologic log entries like 'Clay and gravel', 'Clay, v silty grading to clayey silt, Brown', etc.

7 CONTRACTOR'S OR LANDOWNER'S CERTIFICATION: This water well was (1) constructed, (2) reconstructed, or (3) plugged under my jurisdiction and was completed on (mo/day/year) 1/29/2015 and this record is true to the best of my knowledge and belief.

