


1 LOCATION OF WATER WELL: County: Lincoln Fraction: SE 1/4 SE 1/4 NW 1/4 Section Number: 24 Township Number: T 12 S Range Number: R 10 EW

Distance and direction from nearest town or city street address of well if located within city? 2 miles south of Sylvan Grove, Ks.

2 WATER WELL OWNER: Kenneth Crampton Rt. 2- Box 166 Sylvan Grove, Ks. 67481 Board of Agriculture, Division of Water Resources Application Number: 41,586

3 LOCATE WELL'S LOCATION WITH AN "X" IN SECTION BOX:

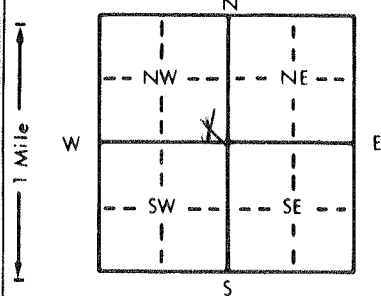

4 DEPTH OF COMPLETED WELL: 47 ft. ELEVATION: ... Depth(s) Groundwater Encountered ... WELL'S STATIC WATER LEVEL: 20 ft. below land surface measured on mo/day/yr 3-29-96 ... Pump test data: Well water was ... Est. Yield: 150 gpm ... Bore Hole Diameter: 20 in. to 47 ft. and ... WELL WATER TO BE USED AS: 2 Irrigation ... Was a chemical/bacteriological sample submitted to Department? Yes ... No ... X ...

5 TYPE OF BLANK CASING USED: 1 Steel, 2 PVC, 3 RMP (SR), 4 ABS, 5 Wrought iron, 6 Asbestos-Cement, 7 Fiberglass, 8 Concrete tile, 9 Other (specify below), 10 Asbestos-cement, 11 Other (specify), 12 None used (open hole) ... CASING JOINTS: Glued X, Clamped, Welded, Threaded ... Blank casing diameter: 12 in. to 32 in., Dia ... Casing height above land surface: 12 in., weight ... SDR 21.6 ... TYPE OF SCREEN OR PERFORATION MATERIAL: 1 Steel, 2 Brass, 3 Stainless steel, 4 Galvanized steel, 5 Fiberglass, 6 Concrete tile, 7 PVC, 8 RMP (SR), 9 ABS, 10 Asbestos-cement, 11 Other (specify), 12 None used (open hole) ... SCREEN OR PERFORATION OPENINGS ARE: 1 Continuous slot, 2 Louvered shutter, 3 Mill slot, 4 Key punched, 5 Gauzed wrapped, 6 Wire wrapped, 7 Torch cut, 8 Saw cut, 9 Drilled holes, 10 Other (specify), 11 None (open hole) ... SCREEN-PERFORATED INTERVALS: From 47 ft. to 32 ft. ... GRAVEL PACK INTERVALS: From 47 ft. to 20 ft. ...

6 GROUT MATERIAL: 1 Neat cement, 2 Cement grout, 3 Bentonite, 4 Other ... Grout Intervals: From 0 ft. to 20 ft. ... What is the nearest source of possible contamination: 1 Septic tank, 2 Sewer lines, 3 Watertight sewer lines, 4 Lateral lines, 5 Cess pool, 6 Seepage pit, 7 Pit privy, 8 Sewage lagoon, 9 Feedyard, 10 Livestock pens, 11 Fuel storage, 12 Fertilizer storage, 13 Insecticide storage, 14 Abandoned water well, 15 Oil well/Gas well, 16 Other (specify below) ... none ...

Direction from well? How many feet? FROM TO LITHOLOGIC LOG FROM TO PLUGGING INTERVALS

FROM	TO	LITHOLOGIC LOG	FROM	TO	PLUGGING INTERVALS
0	3	Top soil			
3	20	Brown clay			
20	25	Sand and clay			
25	47	Sand and gravel			

7 CONTRACTOR'S OR LANDOWNER'S CERTIFICATION: This water well was (1) constructed, (2) reconstructed, or (3) plugged under my jurisdiction and was completed on (mo/day/year) 5-20-96 and this record is true to the best of my knowledge and belief. Kansas Water Well Contractor's License No. 134 This Water Well Record was completed on (mo/day/yr) 6-7-96 under the business name of Rosencrantz-Bemis by (signature) Fredrick Hodson