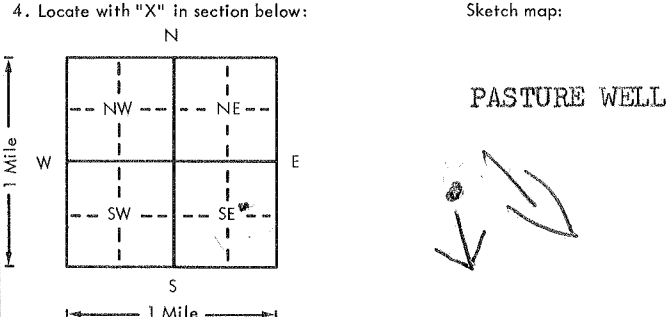


USE TYPEWRITER OR BALL POINT PEN-PRESS FIRMLY, PRINT CLEARLY.

WATER WELL RECORD
KSA 82a-1201-1215

Kansas Department of Health and Environment-Division of Environment (Water well Contractors) Topeka, Kansas 66620

1. Location of well:		County LINCOLN	Fraction SE 1/4 1/4 1/4	Section number 8	Township number T 12 S R 10 E/W	Range number 10																											
2. Distance and direction from nearest town or city: E- 3 MILES. Street address of well location if in city:			3. Owner of well: ROBERT A. GIER R.R. or street: City, state, zip code: SYLVAN GROVE, KANSAS 67481																														
4. Locate with "X" in section below: Sketch map: 			6. Bore hole dia. 7 in. Completion date <input checked="" type="checkbox"/> Well depth 168 ft.																														
5. Type and color of material			7. <input checked="" type="checkbox"/> Cable tool <input type="checkbox"/> Rotary <input type="checkbox"/> Driven <input type="checkbox"/> Dug <input type="checkbox"/> Hollow rod <input type="checkbox"/> Jetted <input type="checkbox"/> Bored <input type="checkbox"/> Reverse rotary																														
<table border="1" style="width:100%; border-collapse: collapse;"> <thead> <tr> <th style="width:80%;"></th> <th style="width:10%;">From</th> <th style="width:10%;">To</th> </tr> </thead> <tbody> <tr> <td>TOPSOIL</td> <td>0</td> <td>5</td> </tr> <tr> <td>LOOSE SAND FINE</td> <td>5</td> <td>35</td> </tr> <tr> <td>SAND ROCK</td> <td>35</td> <td>58</td> </tr> <tr> <td>WHITE CLAY</td> <td>58</td> <td>74</td> </tr> <tr> <td>CLAY BLUISH GREY</td> <td>74</td> <td>95</td> </tr> <tr> <td>CLAY RED</td> <td>95</td> <td>147</td> </tr> <tr> <td>SAND V-FINE</td> <td>147</td> <td>164</td> </tr> <tr> <td>SAND ROCK COURSE</td> <td>164</td> <td>168</td> </tr> </tbody> </table>				From	To	TOPSOIL	0	5	LOOSE SAND FINE	5	35	SAND ROCK	35	58	WHITE CLAY	58	74	CLAY BLUISH GREY	74	95	CLAY RED	95	147	SAND V-FINE	147	164	SAND ROCK COURSE	164	168	8. Use: <input checked="" type="checkbox"/> Domestic <input type="checkbox"/> Public supply <input type="checkbox"/> Industry <input type="checkbox"/> Irrigation <input type="checkbox"/> Air conditioning <input type="checkbox"/> Stock <input type="checkbox"/> Lawn <input type="checkbox"/> Oil field water <input type="checkbox"/> Other			
	From	To																															
TOPSOIL	0	5																															
LOOSE SAND FINE	5	35																															
SAND ROCK	35	58																															
WHITE CLAY	58	74																															
CLAY BLUISH GREY	74	95																															
CLAY RED	95	147																															
SAND V-FINE	147	164																															
SAND ROCK COURSE	164	168																															
(Use a second sheet if needed)			9. Casing: Material pvc Height: Above or below Threaded <input type="checkbox"/> Welded <input type="checkbox"/> Surface <input type="checkbox"/> in. RMP <input type="checkbox"/> PVC <input checked="" type="checkbox"/> Weight 282.8 lbs./ft. 100 Dia. 4 in. to <input type="checkbox"/> ft. depth; Wall Thickness: inches or Dia. <input type="checkbox"/> in. to <input type="checkbox"/> ft. depth; gage No. 265																														
18. Elevation:			10. Screen: Manufacturer's name MODERN PIPE INC Type pvc # 200 Dia. 4 Slot/gauze 1/16 Length 20 ft. Set between 1/2 ft. and 1/8 ft. ft. Gravel pack? <input checked="" type="checkbox"/> Size range of material 1/4-1/8 ft.																														
19. Remarks:			11. Static water level: <input type="checkbox"/> mo./day/yr. <input type="checkbox"/> ft. below land surface Date																														
Topography: <input type="checkbox"/> Hill <input checked="" type="checkbox"/> Slope <input type="checkbox"/> Upland <input type="checkbox"/> Valley			12. Pumping level below land surfaces: bailer test <input type="checkbox"/> ft. after <input type="checkbox"/> hrs. pumping <input type="checkbox"/> g.p.m. <input type="checkbox"/> ft. after <input type="checkbox"/> hrs. pumping <input type="checkbox"/> g.p.m. Estimated maximum yield <input type="checkbox"/> g.p.m.																														
			13. Water sample submitted: <input type="checkbox"/> Yes <input checked="" type="checkbox"/> No Date																														
			14. Well head completion: <input type="checkbox"/> Pitless adapter <input type="checkbox"/> inches above grade																														
			15. Well grouted? <input type="checkbox"/> With: <input type="checkbox"/> Neat cement <input type="checkbox"/> Bentonite <input checked="" type="checkbox"/> Concrete Depth: From <input type="checkbox"/> ft. to 148 ft.																														
			16. Nearest source of possible contamination: ft. <input type="checkbox"/> Direction <input type="checkbox"/> Type <input type="checkbox"/> Well disinfected upon completion? <input type="checkbox"/> Yes <input type="checkbox"/> No																														
			17. Pump: <input checked="" type="checkbox"/> Not installed Manufacturer's name <input type="checkbox"/> Model number <input type="checkbox"/> HP <input type="checkbox"/> Volts <input type="checkbox"/> Length of drop pipe <input type="checkbox"/> ft. capacity <input type="checkbox"/> g.p.m. Type: <input type="checkbox"/> Submersible <input type="checkbox"/> Turbine <input type="checkbox"/> Jet <input type="checkbox"/> Reciprocating <input type="checkbox"/> Centrifugal <input type="checkbox"/> Other																														
			20. Water well contractor's certification: This well was drilled under my jurisdiction and this report is true to the best of my knowledge and belief. 95 so.ks, RUSSELL, KS 260 Business name SMALL'S WATER WELL DRLG. License No. <input type="checkbox"/> Address <input type="checkbox"/> Signed <i>Edwin Small</i> Date <input type="checkbox"/> Authorized representative																														

T 12 S R 10 E W 1/4 1/4 1/4 SE

Forward the white, blue and pink copies to the Department of Health and Environment

Form WWC-5