


1] LOCATION OF WATER WELL: County: Lincoln Fraction SE 1/4 SE 1/4 NW 1/4 Section Number 13 Township Number T 12 S Range Number R 10W E/W

Distance and direction from nearest town or city street address of well if located within city? In Sylvan Grove, Kansas

2] WATER WELL OWNER: Bud Pistora RR#, St. Address, Box #: Sylvan Grove, Kansas 67481 Board of Agriculture, Division of Water Resources City, State, ZIP Code: Route 2 Application Number:

3] LOCATE WELL'S LOCATION WITH AN "X" IN SECTION BOX:

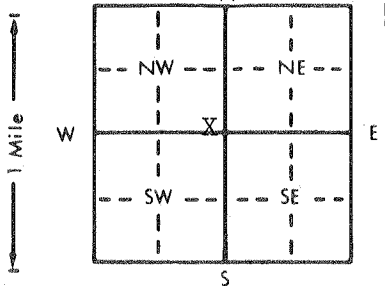

4] DEPTH OF COMPLETED WELL: 95 ft. ELEVATION: Unknown

Depth(s) Groundwater Encountered: 1. 63 ft. 2. ft. 3. ft. WELL'S STATIC WATER LEVEL: 63 ft. below land surface measured on mo/day/yr: 3/26/92 Pump test data: Well water was ft. after hours pumping gpm Est. Yield: 20 gpm: Well water was ft. after hours pumping gpm Bore Hole Diameter: 8 in. to 95 ft. and in. to ft. WELL WATER TO BE USED AS: 5 Public water supply 8 Air conditioning 11 Injection well 1 Domestic 3 Feedlot 6 Oil field water supply 9 Dewatering 12 Other (Specify below) 2 Irrigation 4 Industrial 7 Lawn and garden only 10 Monitoring well Was a chemical/bacteriological sample submitted to Department? Yes No; If yes, mo/day/yr sample was submitted Water Well Disinfected? Yes No

5] TYPE OF BLANK CASING USED: 1 Steel 3 RMP (SR) 5 Wrought iron 8 Concrete tile CASING JOINTS: Glued Clamped 2 PVC 4 ABS 6 Asbestos-Cement 9 Other (specify below) Welded Threaded 7 Fiberglass

Blank casing diameter: 5 in. to 75 ft., Dia in. to ft., Dia in. to ft. Casing height above land surface: 12 in., weight 2.8 lbs./ft. Wall thickness or gauge No. Sch. 40

TYPE OF SCREEN OR PERFORATION MATERIAL: 1 Steel 3 Stainless steel 5 Fiberglass 8 RMP (SR) 10 Asbestos-cement 2 Brass 4 Galvanized steel 6 Concrete tile 9 ABS 11 Other (specify) 12 None used (open hole)

SCREEN OR PERFORATION OPENINGS ARE: 1 Continuous slot 3 Mill slot 5 Gauzed wrapped 8 Saw cut 11 None (open hole) 2 Louvered shutter 4 Key punched 6 Wire wrapped 9 Drilled holes 7 Torch cut 10 Other (specify)

SCREEN-PERFORATED INTERVALS: From 75 ft. to 95 ft., From ft. to ft. GRAVEL PACK INTERVALS: From 20 ft. to 95 ft., From ft. to ft.

6] GROUT MATERIAL: 1 Neat cement 2 Cement grout 3 Bentonite 4 Other Grout Intervals: From 0 ft. to 20 ft., From ft. to ft., From ft. to ft.

What is the nearest source of possible contamination: 1 Septic tank 4 Lateral lines 7 Pit privy 10 Livestock pens 14 Abandoned water well 2 Sewer lines 5 Cess pool 8 Sewage lagoon 11 Fuel storage 15 Oil well/Gas well 3 Watertight sewer lines 6 Seepage pit 9 Feedyard 12 Fertilizer storage 16 Other (specify below) 13 Insecticide storage Direction from well? South How many feet? 150

Table with 6 columns: FROM, TO, LITHOLOGIC LOG, FROM, TO, PLUGGING INTERVALS. Row 1: 0, 45, Clay, (blank), (blank), (blank). Row 2: 45, 95, Sand Rock, (blank), (blank), (blank).

7] CONTRACTOR'S OR LANDOWNER'S CERTIFICATION: This water well was (1) constructed, (2) reconstructed, or (3) plugged under my jurisdiction and was completed on (mo/day/year) 3/26/92 and this record is true to the best of my knowledge and belief. Kansas Water Well Contractor's License No. 186 This Water Well Record was completed on (mo/day/yr) 4/28/92 under the business name of Kelly's Water Well Service, Inc. by (signature)