


1] LOCATION OF WATER WELL: County: <u>Lincoln</u>	Fraction SW 1/4 SW 1/4 NW 1/4	Section Number <u>28</u>	Township Number T 12 S	Range Number R 10 <u>EW</u>
--	----------------------------------	-----------------------------	---------------------------	--------------------------------

Distance and direction from nearest town or city street address of well if located within city?
 Approximately 1 1/2 miles south and 2 3/4 miles west of Sylvan Grove

2] WATER WELL OWNER: Meyer Land & Cattle
 RR#, St. Address, Box # : c/o Chris Meyer
 City, State, ZIP Code : Box 149
Sylvan Grove, KS 67481

Board of Agriculture, Division of Water Resources
 Application Number: _____

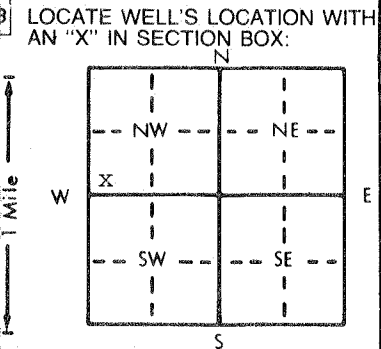

4] DEPTH OF COMPLETED WELL: 94 ft. ELEVATION: unknown

Depth(s) Groundwater Encountered 1. _____ ft. 2. _____ ft. 3. _____ ft.

WELL'S STATIC WATER LEVEL .52 ft. below land surface measured on mo/day/yr 6-17-91

Pump test data: Well water was not ch'd. ft. after _____ hours pumping _____ gpm

Est. Yield unknown gpm: Well water was _____ ft. after _____ hours pumping _____ gpm

Bore Hole Diameter .8 3/4 in. to 1.20 ft., and _____ in. to _____ ft.

WELL WATER TO BE USED AS:

5 Public water supply	8 Air conditioning	11 Injection well
1 Domestic	3 Feedlot	6 Oil field water supply
2 Irrigation	4 Industrial	7 Lawn and garden only
		10 Monitoring well

Stock _____

Was a chemical/bacteriological sample submitted to Department? Yes _____ No X _____; If yes, mo/day/yr sample was submitted _____

Water Well Disinfected? Yes X No _____

5] TYPE OF BLANK CASING USED:

1 Steel	3 RMP (SR)	5 Wrought iron	8 Concrete tile	CASING JOINTS: Glued <u>X</u> Clamped _____
2 PVC	4 ABS	6 Asbestos-Cement	9 Other (specify below)	Welded _____
		7 Fiberglass		Threaded _____

Blank casing diameter 5 in. to 7.2 ft., Dia _____ in. to _____ ft., Dia _____ in. to _____ ft.

Casing height above land surface 24 in., weight 2.36 lbs./ft. Wall thickness or gauge No. 214

TYPE OF SCREEN OR PERFORATION MATERIAL:

1 Steel	3 Stainless steel	5 Fiberglass	8 RMP (SR)	10 Asbestos-cement
2 Brass	4 Galvanized steel	6 Concrete tile	9 ABS	11 Other (specify) _____
				12 None used (open hole)

SCREEN OR PERFORATION OPENINGS ARE:

1 Continuous slot	3 Mill slot	5 Gauzed wrapped	8 Saw cut	11 None (open hole)
2 Louvered shutter	4 Key punched	6 Wire wrapped	9 Drilled holes	
		7 Torch cut	10 Other (specify) _____	

SCREEN-PERFORATED INTERVALS: From 7.2 ft. to 92 ft., From _____ ft. to _____ ft.

GRAVEL PACK INTERVALS: From 67.5 ft. to 92 ft., From _____ ft. to _____ ft.

6] GROUT MATERIAL: 1 Neat cement 2 Cement grout 3 Bentonite 4 Other Bentonite Holeplug

Grout Intervals: From _____ ft. to _____ ft., From _____ ft. to _____ ft., From 0 ft. to 67.5 ft.

What is the nearest source of possible contamination:

1 Septic tank	4 Lateral lines	7 Pit privy	10 Livestock pens	14 Abandoned water well
2 Sewer lines	5 Cess pool	8 Sewage lagoon	11 Fuel storage	15 Oil well/Gas well
3 Watertight sewer lines	6 Seepage pit	9 Feedyard	12 Fertilizer storage	16 Other (specify below)
			13 Insecticide storage	_____ none known

Direction from well? _____ How many feet? _____

FROM	TO	LITHOLOGIC LOG	FROM	TO	PLUGGING INTERVALS
0	6	Topsoil			
6	14	Clay, gray			
14	16	Dakota drift			
16	22	Clay, white, limestone streak			
22	40	Clay, gray, limestone streak			
40	60	Clay, gray and red			
60	72	Clay, gray			
72	91	Sandstone			
91	120	Shale, gray and red			

7] CONTRACTOR'S OR LANDOWNER'S CERTIFICATION: This water well was (1) constructed, (2) reconstructed, or (3) plugged under my jurisdiction and was completed on (mo/day/year) 6-17-91 and this record is true to the best of my knowledge and belief. Kansas Water Well Contractor's License No. 185 This Water Well Record was completed on (mo/day/yr) 7-5-91 under the business name of Clarke Well & Equipment, Inc. by (signature) _____