


1 LOCATION OF WATER WELL: Fraction SE 1/4 SE 1/4 SE 1/4 Section Number 13 Township Number T 12 S Range Number R 10 E/W
 County: Lincoln

Distance and direction from nearest town or city street address of well if located within city?
1 mi. So. 1/8 West of SYLVAN GROVE, Ks.

2 WATER WELL OWNER: Chris Meyer
 RR#, St. Address, Box #: RR1, Box 149 Board of Agriculture, Division of Water Resources
 City, State, ZIP Code: Sylvan Grove, Ks. 67481 Application Number:

3 LOCATE WELL'S LOCATION WITH AN "X" IN SECTION BOX: 4 DEPTH OF COMPLETED WELL: 33 1/2 ELEVATION:

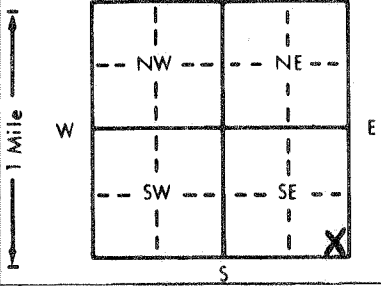

Depth(s) Groundwater Encountered 1. 24' ft. 2. ft. 3. ft.
 WELL'S STATIC WATER LEVEL 24' ft. below land surface measured on mo/day/yr
 Pump test data: Well water was ft. after hours pumping gpm
 Est. Yield 15 gpm; Well water was ft. after hours pumping gpm
 Bore Hole Diameter 8 in. to 33 1/2 in. to ft.
 WELL WATER TO BE USED AS: 5 Public water supply 8 Air conditioning 11 Injection well
 Domestic 3 Feedlot 6 Oil field water supply 9 Dewatering 12 Other (Specify below)
 2 Irrigation 4 Industrial 7 Lawn and garden only 10 Monitoring well LIVESTOCK
 Was a chemical/bacteriological sample submitted to Department? Yes.....No......; If yes, mo/day/yr sample was submitted
 Water Well Disinfected? Yes No

5 TYPE OF BLANK CASING USED: 5 Wrought iron 8 Concrete tile CASING JOINTS: Glued.....Clamped.....
 1 Steel 3 RMP (SR) 6 Asbestos-Cement 9 Other (specify below) Welded.....
 PVC 4 ABS 7 Fiberglass Threaded.....
 Blank casing diameter 5" in. to ft., Dia. in. to ft., Dia. in. to ft.
 Casing height above land surface 12" in., weight lbs./ft. Wall thickness or gauge No. SCH 200

TYPE OF SCREEN OR PERFORATION MATERIAL: 7 PVC 10 Asbestos-cement
 1 Steel 3 Stainless steel 5 Fiberglass 8 RMP (SR) 11 Other (specify).....
 2 Brass 4 Galvanized steel 6 Concrete tile 9 ABS 12 None used (open hole)

SCREEN OR PERFORATION OPENINGS ARE: 5 Gauzed wrapped 8 Saw cut 11 None (open hole)
 1 Continuous slot 3 Mill slot 6 Wire wrapped 9 Drilled holes
 2 Louvered shutter 4 Key punched 7 Torch cut 10 Other (specify) factory Cut

SCREEN-PERFORATED INTERVALS: From 24' ft. to 32' ft., From ft. to ft.
 GRAVEL PACK INTERVALS: From 24' ft. to 33 1/2' ft., From ft. to ft.
 From ft. to ft., From ft. to ft.

6 GROUT MATERIAL: 1 Neat cement 2 Cement grout 3 Bentonite 4 Other.....
 Grout Intervals: From 0' ft. to 24' ft., From ft. to ft., From ft. to ft.

What is the nearest source of possible contamination:
 1 Septic tank 4 Lateral lines 7 Pit privy 10 Livestock pens 14 Abandoned water well
 2 Sewer lines 5 Cess pool 8 Sewage lagoon 11 Fuel storage 15 Oil well/Gas well
 3 Watertight sewer lines 6 Seepage pit 9 Feedyard 12 Fertilizer storage 16 Other (specify below)
3 13 Insecticide storage Creek 1/2 mi. No

Direction from well?		LITHOLOGIC LOG		PLUGGING INTERVALS	
FROM	TO	FROM	TO	FROM	TO
<u>0</u>	<u>3</u>				
<u>3</u>	<u>24</u>				
<u>24</u>	<u>32</u>	<u>Topsoil</u>			
<u>32</u>	<u>33.5</u>	<u>Brown Clay</u>			
		<u>Coarse Sand</u>			
		<u>Red Clay</u>			

7 CONTRACTOR'S OR LANDOWNER'S CERTIFICATION: This water well was constructed, reconstructed, or plugged under my jurisdiction and was completed on (mo/day/year) 3/25/98 and this record is true to the best of my knowledge and belief. Kansas Water Well Contractor's License No. 6019 This Water Well Record was completed on (mo/day/year) 4/21/98 under the business name of Bushell Waterwell Service by (signature) Reta J. Bushell