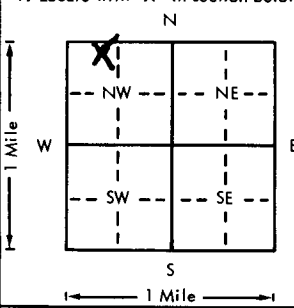


USE TYPEWRITER OR BALL POINT PEN-PRESS FIRMLY, PRINT CLEARLY.

WATER WELL RECORD
KSA 82a-1201-1215

Kansas Department of Health and Environment-Division of Environment
(Water well Contractors)
Topeka, Kansas 66620

| | | | | | | | | | | | |
|---|--|--|--|--|--|--|---|--|---|--|--|
| 1. Location of well: County <u>Russell</u> | | Fraction <u>E 1/2 NW 1/4</u> 1/4 1/4 1/4 | | | Section number <u>14</u> | | Township number T <u>12</u> S R <u>11</u> E/W | | Range number | | |
| 2. Distance and direction from nearest town or city: <u>1 mi East of Lucas + 3 South 1/4 East.</u> Street address of well location if in city: | | | | | 3. Owner of well: <u>Leo Kaufman</u> R.R. or street: <u>Lucas, KS 67648</u> City, state, zip code: | | | | | | |
| 4. Locate with "X" in section below: Sketch map:  | | | | | To P of Hill in Pasture Nothing around to Pall. | | | | | | |
| 5. Type and color of material | | | | | From | | To | | 6. Bore hole dia. <u>8 1/2</u> in. Completion date <u>2-27-78</u> Well depth <u>137</u> ft. <u>8 1/2</u> bore | | |
| <u>yellow Shumbo Clay</u> | | | | | <u>0</u> | | <u>5</u> | | 7. <input checked="" type="checkbox"/> Cable tool <input type="checkbox"/> Rotary <input type="checkbox"/> Driven <input type="checkbox"/> Dug <input type="checkbox"/> Hollow rod <input type="checkbox"/> Jetted <input type="checkbox"/> Bored <input type="checkbox"/> Reverse rotary | | |
| <u>Sand & Clay (Brown to Gray)</u> | | | | | <u>5</u> | | <u>56</u> | | 8. Use: <input type="checkbox"/> Domestic <input type="checkbox"/> Public supply <input type="checkbox"/> Industry <input type="checkbox"/> Irrigation <input type="checkbox"/> Air conditioning <input checked="" type="checkbox"/> Stock <input type="checkbox"/> Low <input type="checkbox"/> Oil field water <input type="checkbox"/> Other | | |
| <u>Red Clay</u> | | | | | <u>56</u> | | <u>76</u> | | 9. Casing: Material <input type="checkbox"/> Height: <u>Above</u> or below Threaded <input type="checkbox"/> Welded <input type="checkbox"/> Surface <u>24</u> in. RMP <input type="checkbox"/> PVC <input checked="" type="checkbox"/> Weight <u>2.8</u> lbs./ft. Dia. <u>5</u> in. to <u>137</u> ft. depth Wall thickness: inches or Dia. <input type="checkbox"/> in. to <input type="checkbox"/> ft. depth gage No. <u>265</u> | | |
| <u>Gray Clay</u> | | | | | <u>76</u> | | <u>87</u> | | 10. Screen: Manufacturer's name <u>Modern Pipe, Inc.</u> Type <u>PVC</u> Dia. <u>5</u> in. Slot/gauze <u>1023</u> Length <u>10</u> ft. Set between <u>127</u> ft. and <u>137</u> ft. ft. and <u>137</u> ft. Gravel pack? <input checked="" type="checkbox"/> Size range of material <u>3/8 x 3/16</u> | | |
| <u>Red clay</u> | | | | | <u>87</u> | | <u>127</u> | | 11. Static water level: <u>60</u> ft. below land surface Date <u>2-27-78</u> mo./day/yr. | | |
| <u>Sand & Gray Clay (wet)</u> | | | | | <u>127</u> | | <u>137</u> | | 12. Pumping level below land surfaces: ft. after <input type="checkbox"/> hrs. pumping <input type="checkbox"/> g.p.m. ft. after <input type="checkbox"/> hrs. pumping <input type="checkbox"/> g.p.m. Estimated maximum yield <u>5</u> g.p.m. | | |
| | | | | | | | | | 13. Water sample submitted: <input type="checkbox"/> Yes <input checked="" type="checkbox"/> No Date | | |
| | | | | | | | | | 14. Well head completion: <input type="checkbox"/> Pitless adapter <input type="checkbox"/> Inches above grade | | |
| | | | | | | | | | 15. Well grouted? <u>yes</u> With: <input checked="" type="checkbox"/> Neat cement <input type="checkbox"/> Bentonite <input checked="" type="checkbox"/> Concrete Depth: From <u>5</u> ft. to <u>17</u> ft. <u>115-125</u> | | |
| | | | | | | | | | 16. Nearest source of possible contamination: ft. <input type="checkbox"/> Direction <input type="checkbox"/> Type <u>NONE</u> Well disinfected upon completion? <input checked="" type="checkbox"/> Yes <input type="checkbox"/> No | | |
| | | | | | | | | | 17. Pump: <input checked="" type="checkbox"/> Not installed Manufacturer's name <input type="checkbox"/> HP <input type="checkbox"/> Volts <input type="checkbox"/> Length of drop pipe <input type="checkbox"/> ft. capacity <input type="checkbox"/> g.p.m. Type: <input type="checkbox"/> Submersible <input type="checkbox"/> Turbine <input type="checkbox"/> Jet <input type="checkbox"/> Reciprocating <input type="checkbox"/> Centrifugal <input type="checkbox"/> Other | | |
| (Use a second sheet if needed) | | | | | | | | | | | |
| 18. Elevation: | | 19. Remarks: <u>Farmer is install'g pump & Pitless Unit.</u> | | | | | 20. Water well contractor's certification: This well was drilled under my jurisdiction and this report is true to the best of my knowledge and belief. <u>Small's Water Well Drill 360</u> Business name <u>95 So. Kansas</u> License No. <u>115-125</u> Address <u>William R. Wagoner</u> Signed <u>3-7-78</u> Date | | | | |

Forward the white, blue and pink copies to the Department of Health and Environment

Form WWC-5

12 110 14 E 1/2 NW