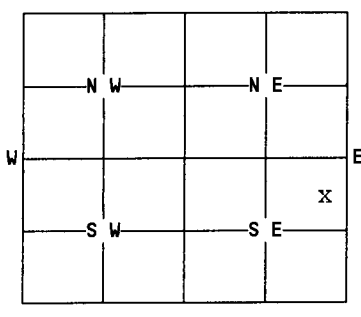


#1

1	LOCATION OF WATER WELL:	Fraction	Section Number	Township Number	Range Number
	County: Russell	SE 1/4 NE 1/4 SE 1/4	11	10	12 W

Distance and direction from nearest town or city street address of well if located within city?
From Lucas, KS 2 1/2 south, 4 miles west and 1 1/2 north

2	WATER WELL OWNER:	Elmer Casper
	RR#, St. Address, Box #:	5301 198th.
	City, State, ZIP Code :	Lucas, KS 67648
		Board of Agriculture, Division of Water Resources
		Application Number:

3	MARK WELL'S LOCATION WITH AN "X" IN SECTION BOX:	4	DEPTH OF WELL.....20.ft.												
	N		WELL'S STATIC WATER LEVEL.....14.ft.												
			WELL WAS USED AS:												
			<table border="0"> <tr> <td>1 Domestic</td> <td>5 Public Water Supply</td> <td>9 Dewatering</td> </tr> <tr> <td>2 Irrigation</td> <td>6 Oil Field Water Supply</td> <td>10 Monitoring Well</td> </tr> <tr> <td><input checked="" type="checkbox"/> 3 Feedlot</td> <td>7 Lawn and Garden Only</td> <td>11 Injection Well</td> </tr> <tr> <td>4 Industrial</td> <td>8 Air Conditioning</td> <td>12 Other.....</td> </tr> </table>	1 Domestic	5 Public Water Supply	9 Dewatering	2 Irrigation	6 Oil Field Water Supply	10 Monitoring Well	<input checked="" type="checkbox"/> 3 Feedlot	7 Lawn and Garden Only	11 Injection Well	4 Industrial	8 Air Conditioning	12 Other.....
1 Domestic	5 Public Water Supply	9 Dewatering													
2 Irrigation	6 Oil Field Water Supply	10 Monitoring Well													
<input checked="" type="checkbox"/> 3 Feedlot	7 Lawn and Garden Only	11 Injection Well													
4 Industrial	8 Air Conditioning	12 Other.....													
			Was a chemical/bacteriological sample submitted to Department? Yes....No. <input checked="" type="checkbox"/> . If yes, mo/day/yr sample was submitted.....												
			Water Well Disinfected: Yes. <input checked="" type="checkbox"/> No.....												

5	TYPE OF BLANK CASING USED:	
	<input checked="" type="checkbox"/> Steel	3 RMP (SR) 5 Wrought 7 Fiberglass 9 Other (specify below)
	2 PVC	4 ABS 6 Asbestos-Cement 8 Concrete Tile
	Blank casing diameter.....6.in. Was casing pulled? Yes. <input checked="" type="checkbox"/> No..... If yes, how much ^{20'}	
	Casing height above or below land surface.....in.	

6	GROUT PLUG MATERIAL: 1 Neat cement 2 Cement grout <input checked="" type="checkbox"/> Bentonite 4 Other.....																				
	Grout Plug Intervals: From..7...ft. to...4...ft., From.....ft. toft., From..... to.....ft.																				
	What is the nearest source of possible contamination:																				
	<table border="0"> <tr> <td>1 Septic tank</td> <td>6 Seepage pit</td> <td>11 Fuel storage</td> <td>16 Other (specify below)</td> </tr> <tr> <td>2 Sewer lines</td> <td>7 Pit privy</td> <td>12 Fertilizer storage</td> <td>.....</td> </tr> <tr> <td>3 Watertight sewer lines</td> <td>8 Sewage lagoon</td> <td>13 Insecticide storage</td> <td>.....</td> </tr> <tr> <td>4 Lateral lines</td> <td>9 Feedyard</td> <td>14 Abandoned water well</td> <td>.....</td> </tr> <tr> <td>5 Cess Pool</td> <td><input checked="" type="checkbox"/> 10 Livestock pens</td> <td>15 Oil well/Gas well</td> <td>.....</td> </tr> </table>	1 Septic tank	6 Seepage pit	11 Fuel storage	16 Other (specify below)	2 Sewer lines	7 Pit privy	12 Fertilizer storage	3 Watertight sewer lines	8 Sewage lagoon	13 Insecticide storage	4 Lateral lines	9 Feedyard	14 Abandoned water well	5 Cess Pool	<input checked="" type="checkbox"/> 10 Livestock pens	15 Oil well/Gas well
1 Septic tank	6 Seepage pit	11 Fuel storage	16 Other (specify below)																		
2 Sewer lines	7 Pit privy	12 Fertilizer storage																		
3 Watertight sewer lines	8 Sewage lagoon	13 Insecticide storage																		
4 Lateral lines	9 Feedyard	14 Abandoned water well																		
5 Cess Pool	<input checked="" type="checkbox"/> 10 Livestock pens	15 Oil well/Gas well																		
	Direction from well? ..southeast..... How many feet? ...200.....																				

FROM	TO	PLUGGING MATERIALS
20	14	chlorinated sand
14	7	clay
7	4	bentonite
4	0	topsoil

7	CONTRACTOR'S OR LANDOWNER'S CERTIFICATION: This water well was plugged under my jurisdiction and was completed on (mo/day/year)....4-12-95..... and this record is true to the best of my knowledge and belief. Kansas Water Well Contractor's License No. E-999..... This Water Well Record was completed on (mo/day/year).....4-24-95..... under the business name ofFred Van Arman, Ks Farm Bureau..... by (signature) <i>Elmer Casper</i>
---	---

INSTRUCTIONS: Use typewriter or ball point pen. Please press firmly and print clearly. Please fill in blanks, underline or circle the correct answers. Send top three copies to Kansas Department of Health and Environment, Bureau of Water, Topeka, Kansas 66620-0001. Telephone: 913/296-3565. Send one to Water Well Owner and retain one for your records.