


#5

| | | | | | |
|---|---|--|-----------------------------|------------------------------|-----------------------------|
| 1 | LOCATION OF WATER WELL: County: RUSSELL | Fraction NW SE 1/4 SE 1/4 NE 1/4 | Section Number 11 | Township Number 12 | Range Number 12 W |
|---|---|--|-----------------------------|------------------------------|-----------------------------|

Distance and direction from nearest town or city street address of well if located within city?
From Lucas, Ks 2 1/2 Miles South, 4 miles West, and 1 1/2 Miles North

| | | | |
|---|--|--|--|
| 2 | WATER WELL OWNER: RR#, St. Address, Box #: City, State, ZIP Code : | ELMER Casper 5301 198th. Lucas, Ks 67648 | Board of Agriculture, Division of Water Resources Application Number: |
|---|--|--|--|

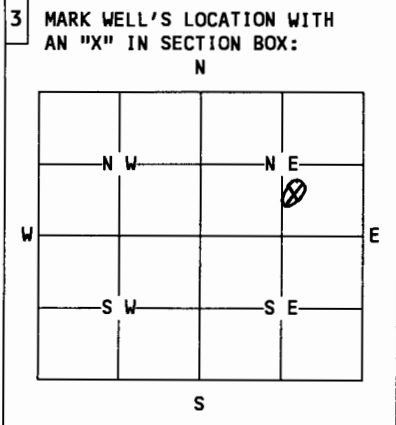

| | |
|---|--|
| 4 | DEPTH OF WELL..... 50ft. WELL'S STATIC WATER LEVEL..... 12ft. WELL WAS USED AS: 1 Domestic 2 Irrigation 3 Feedlot 4 Industrial 5 Public Water Supply 6 Oil Field Water Supply 7 Lawn and Garden Only 8 Air Conditioning 9 Dewatering 10 Monitoring Well 11 Injection Well 12 Other..... Was a chemical/bacteriological sample submitted to Department? Yes....No.. X . If yes, mo/day/yr sample was submitted..... Water Well Disinfected: Yes.. X ... No..... |
|---|--|

| | | |
|---|--|--|
| 5 | TYPE OF BLANK CASING USED: 1 Steel 2 PVC Blank casing diameter..... 6in. Casing height above or below land surface..... 6in. | 3 RMP (SR) 4 ABS 5 Wrought 6 Asbestos-Cement 7 Fiberglass 8 Concrete Tile 9 Other (specify below) Was casing pulled? Yes..... No.. X . If yes, how much... 6 ^{ft} _{cut} |
|---|--|--|

| | |
|---|--|
| 6 | GROUT PLUG MATERIAL: 1 Neat cement 2 Cement grout 3 Bentonite 4 Other..... Grout Plug Intervals: From... 6 ..ft. to... 3 ...ft., From.....ft. toft., From..... to.....ft. What is the nearest source of possible contamination: 1 Septic tank 2 Sewer lines 3 Watertight sewer lines 4 Lateral lines 5 Cess Pool 6 Seepage pit 7 Pit privy 8 Sewage lagoon 9 Feedyard 10 Livestock pens 11 Fuel storage 12 Fertilizer storage 13 Insecticide storage 14 Abandoned water well 15 Oil well/Gas well 16 Other (specify below) Direction from well? South How many feet? 200 |
|---|--|

| FROM | TO | PLUGGING MATERIALS |
|-----------|-----------|-------------------------|
| 50 | 12 | chlorinated Sand |
| 12 | 6 | Clay Soil |
| 6 | 3 | Bentonite |
| 3 | 0 | top soil |
| | | |
| | | |
| | | |

| | |
|---|--|
| 7 | CONTRACTOR'S OR LANDOWNER'S CERTIFICATION: This water well was plugged under my jurisdiction and was completed on (mo/day/year)..... 4-12-95 ... and this record is true to the best of my knowledge and belief. Kansas Water Well Contractor's License No. ... E-999 This Water Well Record was completed on (mo/day/year) ... 4-24-95 ... Under the business name of And. Van. Fabron, Kansas Farm Bureau by (signature) Elmer Casper |
|---|--|

INSTRUCTIONS: Use typewriter or ball point pen. Please press firmly and print clearly. Please fill in blanks, underline or circle the correct answers. Send top three copies to Kansas Department of Health and Environment, Bureau of Water, Topeka, Kansas 66620-0001. Telephone: 913/296-3565. Send one to Water Well Owner and retain one for your records.