

WATER WELL RECORD

Form WWC-5


Division of Water Resources App. No.

Empty box for application number

1 LOCATION OF WATER WELL: County: Russell, Fraction: 1/4 NW 1/4 SE 1/4 SE 1/4, Section Number: 18, Township No.: T 12 S, Range Number: R 13, E/W checked

Street/Rural Address of Well Location; if unknown, distance & direction from nearest town or intersection: 6 3/4 North, 2 1/4 East of Russell. Global Positioning System (GPS) information: Latitude, Longitude, Elevation, Datum, Collection Method.

2 WATER WELL OWNER: Craiq Beran, RR#, Street Address, Box #: 1350 NE 100 Avenue, City, State, ZIP Code: Claflin, Ks. 67525

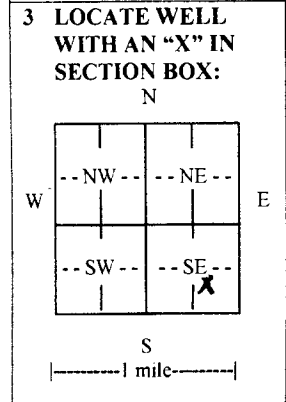

3 LOCATE WELL WITH AN "X" IN SECTION BOX: 4 DEPTH OF COMPLETED WELL 78 ft. Depth(s) Groundwater Encountered (1) 19 ft. (2) 78 ft. (3) 78 ft. WELL'S STATIC WATER LEVEL 19 ft. below land surface measured on mo/day/yr. 6/29/12. Pump test data: Well water was... EST. YIELD. N/A gpm. Well water was... Bore Hole Diameter 10 in. to 78 ft. and... WELL WATER TO BE USED AS: Public water supply, Geothermal, Injection well, Domestic, Feedlot, Oil field water supply, Dewatering, Other (Specify below) Stock, Irrigation, Industrial, Domestic-lawn & garden, Monitoring well. Was a chemical/bacteriological sample submitted to Department? Yes No. If yes, mo/day/yr sample was submitted. Water well disinfected? Yes No.

5 TYPE OF CASING USED: Steel, PVC checked, Other. CASING JOINTS: Glued checked, Clamped, Welded, Threaded. Casing diameter 5 in. to 78 ft., Diameter in. to... Casing height above land surface 18 in., Weight SDR-26 lbs./ft., Wall thickness or gauge No. TYPE OF SCREEN OR PERFORATION MATERIAL: Steel, Stainless Steel, PVC checked, Other (Specify). SCREEN OR PERFORATION OPENINGS ARE: Continuous slot, Mill slot, Gauze wrapped, Torch cut, Drilled holes, None (open hole), Louvered shutter, Key punched, Wire wrapped, Saw cut checked, Other (specify). SCREEN-PERFORATED INTERVALS: From 78 ft. to 58 ft., From... GRAVEL PACK INTERVALS: From 78 ft. to 20 ft., From...

6 GROUT MATERIAL: Neat cement, Cement grout, Bentonite checked, Other. Grout Intervals: From... ft. to... ft., From 20 ft. to 0 ft., From... ft. to... ft. What is the nearest source of possible contamination: Septic tank, Lateral lines, Pit privy, Livestock pens, Insecticide storage, Other (specify below) Garage checked, Sewer lines, Cesspool, Sewage lagoon, Fuel storage, Abandoned water well, Watertight sewer lines, Seepage pit, Feedyard, Fertilizer storage, Oil well/gas well. Direction from well West, Distance from well 40ft.

Table with columns: FROM, TO, LITHOLOGIC LOG, FROM, TO, LITHO. LOG (cont.) or PLUGGING INTERVALS. Rows: 0-5 Top soil & broken rock, 5-22 Sandstone, 22-43 Gray shale, 43-77 Sandstone, 77-78 Gray shale.

7 CONTRACTOR'S OR LANDOWNER'S CERTIFICATION: This water well was constructed checked, reconstructed, or plugged under my jurisdiction and was completed on (mo/day/year) 6/29/12 and this record is true to the best of my knowledge and belief. Kansas Water Well Contractor's License No. 134. This Water Well Record was completed on (mo/day/year) 7/5/12 under the business name of Rosencrantz-Bemis by (signature) [Signature]

INSTRUCTIONS: Use typewriter or ball point pen. PLEASE PRESS FIRMLY and PRINT clearly. Please fill in blanks and check the correct answers. Send three copies (white, blue, pink) to Kansas Department of Health and Environment, Bureau of Water, Geology Section, 1000 SW Jackson St., Suite 420, Topeka, Kansas 66612-1367. Telephone 785-296-5524. Send one copy to WATER WELL OWNER and retain one for your records. Include fee of \$5.00 for each constructed well. Visit us at http://www.kdheks.gov/waterwell/index.html.