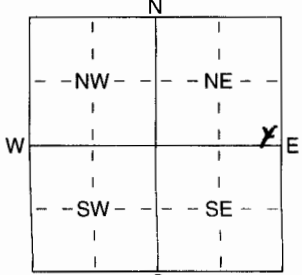


1 LOCATION OF WATER WELL: Fraction SE 1/4 SE 1/4 NE 1/4 Section Number 11 Township Number T 12 S Range Number R 15 E  
 County: Russell

Distance and direction from nearest town or city street address of well if located within city?  
Russell 281st + 40 North 281st + 5m Mellard RD, west 5m on Mellard RD to 160th st then N 1/2 on West into.

2 WATER WELL OWNER: John Driscoll  
 RR#, St. Address, Box # : P.O. Box 65 Board of Agriculture, Division of Water Resources  
 City, State, ZIP Code : Russell, KS 67665 Application Number:

3 LOCATE WELL'S LOCATION WITH AN "X" IN SECTION BOX:  4 DEPTH OF COMPLETED WELL ..... 166 ..... ft. ELEVATION: .....  
 Depth(s) Groundwater Encountered 1 ..... 138 ..... ft. 2 ..... ft. 3 ..... ft.  
 WELL'S STATIC WATER LEVEL ..... 138 ..... ft. below land surface measured on mo/day/yr .....  
 Pump test data: Well water was ..... 166 ..... ft. after ..... 4 ..... hours pumping ..... 5 ..... gpm  
 Est. Yield ..... 5 ..... gpm: Well water was ..... ft. after ..... hours pumping ..... gpm  
 WELL WATER TO BE USED AS: 5 Public water supply 8 Air conditioning 11 Injection well  
 Domestic 3 Feedlot 6 Oil field water supply 9 Dewatering 12 Other (Specify below)  
 Irrigation 4 Industrial 7 Domestic (lawn & garden) 10 Monitoring well .....  
 Was a chemical/bacteriological sample submitted to Department? Yes ..... No .....; If yes, mo/day/yr sample was submitted  
 Water Well Disinfected?  Yes No

5 TYPE OF BLANK CASING USED: 5 Wrought iron 8 Concrete tile CASING JOINTS:  Glued ..... Clamped .....  
 1 Steel 3 RMP (SR) 6 Asbestos-Cement 9 Other (specify below) Welded .....  
 2 PVC 4 ABS 7 Fiberglass Threaded .....  
 Blank casing diameter ..... 5 ..... in. to ..... 146 ..... ft., Dia ..... in. to ..... ft., Dia ..... in. to ..... ft.  
 Casing height above land surface ..... 24 ..... in., weight ..... 2.8 ..... lbs./ft. Wall thickness or guage No. sch 40  
 TYPE OF SCREEN OR PERFORATION MATERIAL:  PVC 10 Asbestos-Cement  
 1 Steel 3 Stainless Steel 5 Fiberglass 8 RMP (SR) 11 Other (Specify) .....  
 2 Brass 4 Galvanized Steel 6 Concrete tile 9 ABS 12 None used (open hole)  
 SCREEN OR PERFORATION OPENINGS ARE: 5 Gauzed wrapped 8 Saw cut 11 None (open hole)  
 1 Continuous slot  3 Mill slot 6 Wire wrapped 9 Drilled holes  
 2 Louvered shutter 4 Key punched 7 Torch cut 10 Other (specify) ..... ft.  
 SCREEN-PERFORATED INTERVALS: From ..... 146 ..... ft. to ..... 166 ..... ft., From ..... ft. to ..... ft.  
 GRAVEL PACK INTERVALS: From ..... 105 ..... ft. to ..... 166 ..... ft., From ..... ft. to ..... ft.

6 GROUT MATERIAL: 1 Neat cement 2 Cement grout  3 Bentonite 4 Other .....  
 Grout Intervals: From ..... 0 ..... ft. to ..... 105 ..... ft., From ..... ft. to ..... ft., From ..... ft. to ..... ft.  
 What is the nearest source of possible contamination:  
 1 Septic tank 4 Lateral lines 7 Pit privy 10 Livestock pens 14 Abandoned water well  
 2 Sewer lines 5 Cess pool 8 Sewage lagoon 11 Fuel storage 15 Oil well/Gas well  
 3 Watertight sewer lines 6 Seepage pit 9 Feedyard 12 Fertilizer storage 16 Other (specify below)  
 13 Insecticide storage .....  
 Direction from well? pasture How many feet?

FROM	TO	LITHOLOGIC LOG	FROM	TO	PLUGGING INTERVALS
<u>0</u>	<u>3</u>	<u>Top Soil</u>			
<u>3</u>	<u>30</u>	<u>Limestone + Blue shale</u>			
<u>30</u>	<u>105</u>	<u>Blue shale</u>			
<u>105</u>	<u>120</u>	<u>gray clay + black shale</u>			
<u>120</u>	<u>140</u>	<u>Blue clay + black shale</u>			
<u>140</u>	<u>161</u>	<u>Brown clay + white clay sandstone</u>			
<u>161</u>	<u>166</u>	<u>Brown clay + black shale</u>			

7 CONTRACTOR'S OR LANDOWNER'S CERTIFICATION: This water well was  constructed,  reconstructed, or  plugged under my jurisdiction and was completed on (mo/day/year) ..... Oct 9 '09 ..... and this record is true to the best of my knowledge and belief. Kansas Water Well Contractor's Licence No 776 ..... This Water Well Record was completed on (mo/day/yr) ..... Oct 22 '09 ..... under the business name of Rainey Water Well by (signature) Tony Rainey