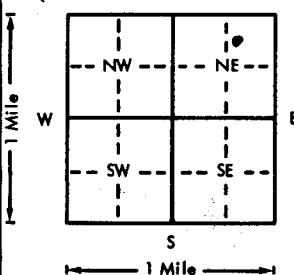
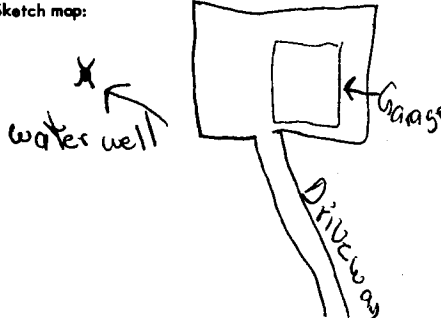


USE TYPEWRITER OR BALL POINT PEN-PRESS FIRMLY, PRINT CLEARLY.

WATER WELL RECORD  
KSA 82a-1201-1215

Kansas Department of Health and Environment-Division of Environment (Water well Contractors) Topeka, Kansas 66620

|   |                       |   |  |  |  |
|---|-----------------------|---|--|--|--|
| 1. Location of well:  | County <u>Russell</u> | Fraction <u>NW 1/4 NE 1/4 NE 1/4</u>  | Section number <u>32</u>                     | Township number <u>T 12</u>  | Range number <u>S R 15 E 1</u>   |
| 2. Distance and direction from nearest town or city: <u>6 N 3/4 E of Gorham</u>   |                       |   | 3. Owner of well: <u>Herbert Weigel</u>      |  |  |
| Street address of well location if in city:   |                       |   | R.R. or street:                              |  |  |
|   |                       |   | City, state, zip code: <u>Gorham, Kansas</u> |  |  |
| <input checked="" type="checkbox"/> Locate with "X" in section below:<br> |                       | Sketch map:<br> |  | 6. Bore hole dia. <u>7 3/4</u> in. Completion date <u>4/16/76</u><br>Well depth <u>184</u> ft.   |  |
|   |                       |   |  | 7. <input checked="" type="checkbox"/> Cable tool <input checked="" type="checkbox"/> Rotary <input type="checkbox"/> Driven <input type="checkbox"/> Dug<br><input type="checkbox"/> Hollow rod <input type="checkbox"/> Jetted <input type="checkbox"/> Bored <input type="checkbox"/> Reverse rotary  |  |
|   |                       |   |  | 8. Use: <input type="checkbox"/> Domestic <input type="checkbox"/> Public supply <input type="checkbox"/> Industry<br><input type="checkbox"/> Irrigation <input type="checkbox"/> Air conditioning <input checked="" type="checkbox"/> Stock<br><input type="checkbox"/> Lawn <input type="checkbox"/> Oil field water <input type="checkbox"/> Other   |  |
|   |                       |   |  | 9. Casing: Material <u>PVC</u> Height: <u>Above</u> or below<br>Threaded <input type="checkbox"/> Welded <input checked="" type="checkbox"/> Surface <u>12</u> in.<br>RMP <input type="checkbox"/> PVC <input checked="" type="checkbox"/> Weight <u>12</u> lbs./ft.<br>Dia. <u>5</u> in. to <u>184</u> ft. depth Wall thickness: inches or<br>Dia. <u>5</u> in. to <u>184</u> ft. depth gage No. <u>258</u> |  |
| 5. Type and color of material   |                       |   | From   | To   | 10. Screen: Manufacturer's name <u>Jet Stream</u>  |
| <u>Topsoil</u>  |                       |   | <u>0</u>                                     | <u>3</u>   | Type <u>PVC</u> Dia. <u>5"</u>   |
| <u>Lime Stone</u>   |                       |   | <u>3</u>                                     | <u>40</u>  | Slot gauze <u>20'</u> Length <u>20'</u>  |
| <u>Blue shale</u>   |                       |   | <u>40</u>                                    | <u>110</u>   | Set between <u>160</u> ft. and <u>180</u> ft.  |
| <u>Soap Stone</u>   |                       |   | <u>110</u>                                   | <u>165</u>   | ft. and <u>180</u> ft.   |
| <u>Sand Stone</u>   |                       |   | <u>165</u>                                   | <u>180</u>   | Gravel pack? <u>YES</u> Size range of material <u>1/4"</u>   |
| <u>Fire Clay</u>  |                       |   | <u>180</u>                                   | <u>184</u>   |  |
|   |                       |   |  |  | 11. Static water level: <u>140</u> ft. below land surface Date <u>4/16/76</u>  |
|   |                       |   |  |  | 12. Rumping level below land surfaces:<br><u>145</u> ft. after <u>1</u> hrs. pumping <u>10</u> g.p.m.<br>___ ft. after ___ hrs. pumping ___ g.p.m.<br>Estimated maximum yield <u>10</u> g.p.m.   |
|   |                       |   |  |  | 13. Water sample submitted: ___ Yes <input checked="" type="checkbox"/> No Date ___  |
|   |                       |   |  |  | 14. Well head completion:<br><input checked="" type="checkbox"/> Pitless adapter ___ inches above grade<br><input checked="" type="checkbox"/> Well grouted? <u>YES</u><br>With: ___ Neat cement ___ Bentonite <input checked="" type="checkbox"/> Concrete<br>Depth: From <u>4</u> ft. to <u>12</u> ft.   |
|   |                       |   |  |  | 16. Nearest source of possible contamination: <u>None</u><br>ft. ___ Direction ___ Type ___<br>Well disinfected upon completion? <input checked="" type="checkbox"/> Yes ___ No  |
|   |                       |   |  |  | 17. Pump: Not installed<br>Manufacturer's name <u>F&amp;W</u><br>Model number <u>78A7</u> HP <u>3/4</u> Volts <u>220</u><br>Length of drop pipe <u>160</u> ft. capacity <u>10</u> g.p.m.<br>Type:<br><input checked="" type="checkbox"/> Submersible ___ Turbine<br>___ Jet ___ Reciprocating<br>___ Centrifugal ___ Other                       |
|   |                       |   |  |  | 18. Elevation: ___   |
| 19. Remarks: <u>Salty</u><br><u>None</u>  |                       |   |  |  | 20. Water well contractor's certification:<br>This well was drilled under my jurisdiction and this report is true to the best of my knowledge and belief.<br><u>Karst water well 199A</u><br>Business name <u>E Hwy 40 Hays</u> License No. ___<br>Address <u>160</u> Date <u>4/16/76</u><br>Signed <u>[Signature]</u> Authorized representative |

Forward the white, blue and pink copies to the Department of Health and Environment

Form WWC-5