USE TYPEWRITER OR BALL POINT PEN-PRESS FIRMLY, PRINT CLEARLY.

WATER WELL RECORD
KSA 82a-1201-1215

Kansas Department of Health and Environment-Division of Environment
(Water well Contractors)
Topeka, Kansas 66620

1. Location of well:	County	Fraction	Section number	Township number	Range number
	ELLIS	SW 1/4 NW 1/4 NE 1/4	29	T 12 S	R 17 E/W (W)

2. Distance and direction from nearest town or city: 4 N 1/2 W
Street address of well location if in city: CATHARINE KS.

3. Owner of well: Celly Schmeidler
R.R. or street: Catharine Rt.
City, state, zip code: Hays, Ks. 67601

4. Locate with "X" in section below:

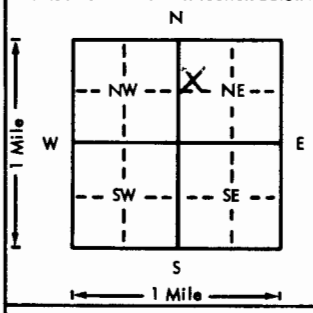

Sketch map:

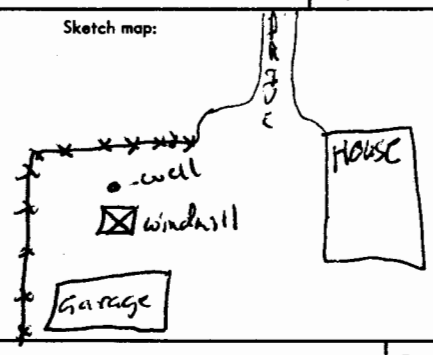

5. Type and color of material	From	To
Topsoil	0	4
Fine to medium sand	4	26
Blue shale	26	30

(Use a second sheet if needed)

6. Bore hole dia. 9 in. Completion date
Well depth 30 ft. 6-11-77

7. __ Cable tool ✓ Rotary __ Driven __ Dug
__ Hollow rod __ Jetted __ Bored __ Reverse rotary

8. Use: ✓ Domestic __ Public supply __ Industry
__ Irrigation __ Air conditioning __ Stock
__ Lawn __ Oil field water __ Other

9. Casing: Material
Threaded __ Welded ✓
RMP __ PVC ✓
Dia. 5 in. to 30 ft. depth
Dia. __ in. to __ ft. depth
Height: Above or below Surface 16 in.
Weight __ lbs./ft.
Wall Thickness: inches or gage No. 160 PSI

10. Screen: Manufacturer's name Jet Stream
Type PVC Dia. 5"
Slot/gauze Length 10'
Set between 20 ft. and 30 ft.
ft. and ft.
Gravel pack? yes Size range of material 1/4-1/8

11. Static water level: mo./day/yr.
20 ft. below land surface Date 6-11-77

12. Pumping level below land surfaces:
20 ft. after 1 hrs. pumping 10 g.p.m.
ft. after hrs. pumping g.p.m.
Estimated maximum yield g.p.m.

13. Water sample submitted: mo./day/yr.
__ Yes ✓ No Date

14. Well head completion:
__ Pitless adapter 16 Inches above grade

15. Well grouted? yes
With: __ Neat cement __ Bentonite ✓ Concrete
Depth: From top ft. to 10 ft.

16. Nearest source of possible contamination: none
ft. Direction Type
Well disinfected upon completion? X Yes __ No

17. Pump: ✓ Not installed
Manufacturer's name
Model number HP Volts
Length of drop pipe ft. capacity g.p.m.
Type:
__ Submersible __ Turbine
__ Jet __ Reciprocating
__ Centrifugal __ Other

18. Elevation:

Topography:
__ Hill
X Slope
__ Upland
__ Valley

19. Remarks:

20. Water well contractor's certification:
This well was drilled under my jurisdiction and this report is true to the best of my knowledge and belief.
Karst Water Well Drld
Business name License No.
Address Hiway 40 Hays 199A
Signed Authorized representative Date 6-11-77

T 12 R 17 E/W (W) Sec 29 1/4 SW 1/4 1/4 1/4

Forward the white, blue and pink copies to the Department of Health and Environment

Form WWC-5

M1-1023