


1 LOCATION OF WATER WELL: Fraction  $\frac{1}{4}$  SW  $\frac{1}{4}$  SE  $\frac{1}{4}$  Section Number 16 Township Number T 12 S Range Number R 18 E/W

Distance and direction from nearest town or city street address of well if located within city?  
 6 MILES NORTH OF HAYS 1/2 MILE WEST

2 WATER WELL OWNER: RR#, St. Address, Box #: AIAN GABEL Board of Agriculture, Division of Water Resources  
 City, State, ZIP Code: HAY KS 67601 Application Number:

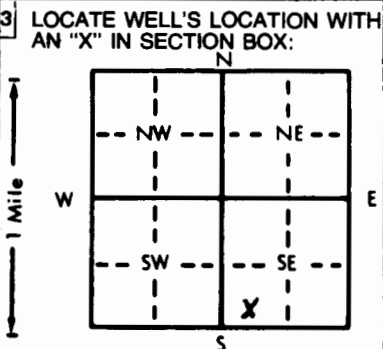

4 DEPTH OF COMPLETED WELL: 81' ft. ELEVATION:  
 Depth(s) Groundwater Encountered 1. 8' ft. 2. ft. 3. ft.  
 WELL'S STATIC WATER LEVEL: 3' ft. below land surface measured on mo/day/yr  
 Pump test data: Well water was ft. after hours pumping gpm  
 Est. Yield 3 gpm: Well water was ft. after hours pumping gpm  
 Bore Hole Diameter: 10" in. to 81' ft., and in. to ft.  
 WELL WATER TO BE USED AS:  
 1 Domestic 3 Feedlot 6 Oil field water supply 9 Dewatering 12 Other (Specify below)  
 2 Irrigation 4 Industrial 7 Lawn and garden only 10 Observation well  
 Was a chemical/bacteriological sample submitted to Department? Yes.....No.....; If yes, mo/day/yr sample was submitted  
 Water Well Disinfected? Yes  No

5 TYPE OF BLANK CASING USED:  
 1 Steel 3 RMP (SR) 5 Wrought iron 8 Concrete tile CASING JOINTS: Glued.....Clamped.....  
 2 PVC 4 ABS 6 Asbestos-Cement 9 Other (specify below) Welded.....  
 7 Fiberglass Threaded.....  
 Blank casing diameter 5 in. to 81' ft., Dia. in. to ft., Dia. in. to ft.  
 Casing height above land surface 12 in., weight lbs./ft. Wall thickness or gauge No. SDR 26  
 TYPE OF SCREEN OR PERFORATION MATERIAL:  
 1 Steel 3 Stainless steel 5 Fiberglass 8 RMP (SR) 10 Asbestos-cement  
 2 Brass 4 Galvanized steel 6 Concrete tile 9 ABS 11 Other (specify).....  
 12 None used (open hole)  
 SCREEN OR PERFORATION OPENINGS ARE:  
 1 Continuous slot 3 Mill slot 5 Gauzed wrapped 8 Saw cut 11 None (open hole)  
 2 Louvered shutter 4 Key punched 6 Wire wrapped 9 Drilled holes  
 7 Torch cut 10 Other (specify).....  
 SCREEN-PERFORATED INTERVALS: From 81' ft. to 61' ft., From ft. to ft.  
 From 15' ft. to 25' ft., From ft. to ft.  
 GRAVEL PACK INTERVALS: From ft. to ft., From ft. to ft.  
 From ft. to ft., From ft. to ft.

6 GROUT MATERIAL: 1 Neat cement 2 Cement grout 3 Bentonite 4 Other.....  
 Grout Intervals: From 3' ft. to 15' ft., From ft. to ft., From ft. to ft.  
 What is the nearest source of possible contamination:  
 1 Septic tank 4 Lateral lines 7 Pit privy 10 Livestock pens 14 Abandoned water well  
 2 Sewer lines 5 Cess pool 8 Sewage lagoon 11 Fuel storage 15 Oil well/Gas well  
 3 Watertight sewer lines 6 Seepage pit 9 Feedyard 12 Fertilizer storage 16 Other (specify below)  
 13 Insecticide storage  
 Direction from well? 60' to SEPTIC TANK (WEST) How many feet? LIVESTOCK PENS 6' EAST

FROM	TO	LITHOLOGIC LOG	FROM	TO	LITHOLOGIC LOG
0	2	TDP SOIL			
2	7	DARK COLORED CLAY			
7	16	LIME STONE GRAVEL			
16	78	LIME STONE ROCK			
78	81	CHANGED TO SAND			

7 CONTRACTOR'S OR LANDOWNER'S CERTIFICATION: This water well was (1) constructed, (2) reconstructed, or (3) plugged under my jurisdiction and was completed on (mo/day/year) 5-12-89 and this record is true to the best of my knowledge and belief. Kansas  
 Water Well Contractor's License No. 478 This Water Well Record was completed on (mo/day/yr) under the business name of PFANNENSTIEL WATER WELL by (signature) [Signature]  
 INSTRUCTIONS: Use typewriter or ball point pen. PLEASE PRESS FIRMLY and PRINT clearly. Please fill in blanks, underline or circle the correct answers. Send top three copies to Kansas Department of Health and Environment, Office of Oil Field and Environmental Geology, Regulation and Permitting Section, Topeka, Kansas 66620-7500, Telephone: 913-862-9360. Send one to WATER WELL OWNER and retain one for your records.