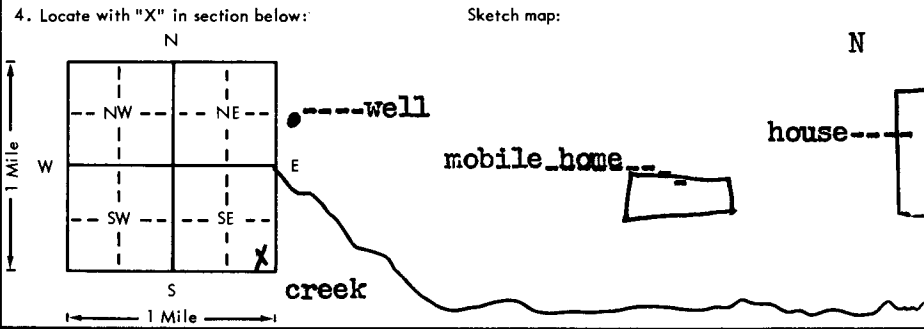


USE TYPEWRITER OR BALL POINT PEN-PRESS FIRMLY, PRINT CLEARLY.

WATER WELL RECORD
KSA 82a-1201-1215

Kansas Department of Health and Environment-Division of Environment
(Water well Contractors)
Topeka, Kansas 66620

1. Location of well:	County Ellis	Fraction SE 1/4 SE 1/4 SE 1/4	Section number 24	Township number T 12 S	Range number R 18 E
2. Distance and direction from nearest town or city: 5 north 1 east 1 north 2 east of Hays, Ks.			3. Owner of well: Merle Crissman R.R. or street: RR City, state, zip code: Hays, Ks.		
4. Locate with "X" in section below: 			6. Bore hole dia. 9 in. Completion date 9-21-79 Well depth 35 ft.		
5. Type and color of material			7. <input type="checkbox"/> Cable tool <input checked="" type="checkbox"/> Rotary <input type="checkbox"/> Driven <input type="checkbox"/> Dug <input type="checkbox"/> Hollow rod <input type="checkbox"/> Jetted <input type="checkbox"/> Bored <input type="checkbox"/> Reverse rotary		
			8. Use: <input checked="" type="checkbox"/> Domestic <input type="checkbox"/> Public supply <input type="checkbox"/> Industry <input type="checkbox"/> Irrigation <input type="checkbox"/> Air conditioning <input type="checkbox"/> Stock <input type="checkbox"/> Lawn <input type="checkbox"/> Oil field water <input type="checkbox"/> Other		
topsoil			9. Casing: Material pvc Height: Above or below Threaded <input type="checkbox"/> Welded <input checked="" type="checkbox"/> Surface 48 in. RMP <input type="checkbox"/> PVC <input checked="" type="checkbox"/> Weight 200 lbs./ft. Dia. 5 in. to 35 ft. depth Wall Thickness: inches or Dia. <input type="checkbox"/> in. to <input type="checkbox"/> ft. depth Gage No. .26		
gumbo- clay			10. Screens: Manufacturer's name jet stream Type pvc Dia. 5 Slot/gauge .031 Length 10 Set between 25 ft. and 35 ft. <input type="checkbox"/> ft. and <input type="checkbox"/> ft. Gravel pack? <input checked="" type="checkbox"/> Size range of material 1/4-1/2		
sand			11. Static water level: 25 ft. below land surface Date 9-21-79 mo./day/yr.		
blue shale			12. Pumping level below land surfaces: 28 ft. after 1 hrs. pumping 10 g.p.m. ft. after hrs. pumping g.p.m. Estimated maximum yield 10 g.p.m.		
			13. Water sample submitted: mo./day/yr. Yes <input checked="" type="checkbox"/> No <input type="checkbox"/> Date		
			14. Well head completion: <input checked="" type="checkbox"/> Pitless adapter _____ inches above grade		
			15. Well grouted? <input checked="" type="checkbox"/> With: <input checked="" type="checkbox"/> Neat cement <input type="checkbox"/> Bentonite <input type="checkbox"/> Concrete Depth: From 2 1/2 ft. to 14 ft.		
			16. Nearest source of possible contamination: ft. 400 Direction north Type sewer Well disinfected upon completion? <input checked="" type="checkbox"/> Yes <input type="checkbox"/> No		
			17. Pump: F&W Not installed Manufacturer's name 1 HP 10ba15 Volts 220 Length of drop pipe 30 ft. capacity 10 g.p.m. Type: <input checked="" type="checkbox"/> Submersible <input type="checkbox"/> Turbine <input type="checkbox"/> Jet <input type="checkbox"/> Reciprocating <input type="checkbox"/> Centrifugal <input type="checkbox"/> Other		
(Use a second sheet if needed)			20. Water well contractor's certification: This well was drilled under my jurisdiction and this report is true to the best of my knowledge and belief. Karst Water Well 199 Business name E. Hiway 40 Hays, Ks. Lic. No. _____ Address The Karst Signed The Karst Date 9-21-79 Authorized representative		
18. Elevation:	19. Remarks:				
Topography: <input type="checkbox"/> Hill <input type="checkbox"/> Slope <input checked="" type="checkbox"/> Upland <input type="checkbox"/> Valley					

T 12 S R 18 E Sec 24 SE SE SE SE

Forward the white, blue and pink copies to the Department of Health and Environment

Form WWC-5