


1 LOCATION OF WATER WELL: County: Ekhus Fraction: SW 1/4 SW 1/4 SW 1/4 Section Number: 27 Township Number: T 12 S Range Number: R 18 E (W)

Distance and direction from nearest town or city street address of well if located within city?
5 miles south of Hays KS on Hwy 183

2 WATER WELL OWNER: Francis C. Staab
 RR#, St. Address, Box #: 1960-290th Av Board of Agriculture, Division of Water Resources
 City, State, ZIP Code: Hays KS 67601 Application Number:

3 LOCATE WELL'S LOCATION WITH AN "X" IN SECTION BOX:

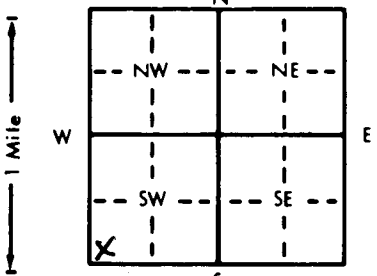

4 DEPTH OF COMPLETED WELL: 70 ft. ELEVATION:
 Depth(s) Groundwater Encountered 1. 45 ft. 2. _____ ft. 3. _____ ft.
 WELL'S STATIC WATER LEVEL: 46 ft. below land surface measured on mo/day/yr 5-23-94
 Pump test data: Well water was 20 ft. after 1 hours pumping 12 gpm
 Est. Yield 20 gpm; Well water was _____ ft. after _____ hours pumping _____ gpm
 Bore Hole Diameter: 10 in. to _____ ft., and _____ in. to _____ ft.
 WELL WATER TO BE USED AS:
 Domestic Feedlot Oil field water supply Air conditioning Injection well
 Irrigation Industrial Lawn and garden only Dewatering Monitoring well Other (Specify below)
 Was a chemical/bacteriological sample submitted to Department? Yes _____ No If yes, mo/day/yr sample was submitted _____
 Water Well Disinfected? Yes No

5 TYPE OF BLANK CASING USED:
 Steel RMP (SR) Concrete tile CASING JOINTS: Glued Clamped
 PVC ABS Asbestos-Cement Other (specify below) Welded
 Wrought iron Fiberglass Threaded
 Blank casing diameter: 5 in. to _____ ft., Dia _____ in. to _____ ft., Dia _____ in. to _____ ft.
 Casing height above land surface: 20 in., weight _____ lbs./ft. Wall thickness or gauge No. SOR-2L

TYPE OF SCREEN OR PERFORATION MATERIAL:
 Steel Stainless steel Fiberglass 7 PVC 10 Asbestos-cement
 Brass Galvanized steel Concrete tile 8 RMP (SR) 11 Other (specify) _____
 2 Brass 4 Galvanized steel 6 Concrete tile 9 ABS 12 None used (open hole)

SCREEN OR PERFORATION OPENINGS ARE:
 Continuous slot 3 Mill slot 5 Gauzed wrapped 8 Saw cut 11 None (open hole)
 Louvered shutter 4 Key punched 6 Wire wrapped 9 Drilled holes
 7 Torch cut 10 Other (specify) _____

SCREEN-PERFORATED INTERVALS: From 40 ft. to 70 ft., From _____ ft. to _____ ft.
 From _____ ft. to _____ ft., From _____ ft. to _____ ft.
 GRAVEL PACK INTERVALS: From 30 ft. to 70 ft., From _____ ft. to _____ ft.
 From _____ ft. to _____ ft., From _____ ft. to _____ ft.

6 GROUT MATERIAL: Neat cement Cement grout Bentonite Other _____
 Grout intervals: From 7 ft. to 27 ft., From _____ ft. to _____ ft., From _____ ft. to _____ ft.

What is the nearest source of possible contamination:
 Septic tank Lateral lines Pit privy 10 Livestock pens 14 Abandoned water well
 Sewer lines Cess pool Sewage lagoon 11 Fuel storage 15 Oil well/Gas well
 Watertight sewer lines Seepage pit 9 Feedyard 12 Fertilizer storage 16 Other (specify below)
 13 Insecticide storage
 Direction from well? Northeast How many feet? 200-250'

FROM	TO	LITHOLOGIC LOG	FROM	TO	PLUGGING INTERVALS
0	2	Top soil			
2	45	White limestone Rock			
45	48	Yellow limestone Rock			
48	65	White limestone Rock			
65	70	Shale			

7 CONTRACTOR'S OR LANDOWNER'S CERTIFICATION: This water well was constructed, reconstructed, or plugged under my jurisdiction and was completed on (mo/day/year) 5-23-94 and this record is true to the best of my knowledge and belief. Kansas Water Well Contractor's License No. 27L This Water Well Record was completed on (mo/day/yr) 5-23-94 under the business name of HYEA Water Well Drilling by (signature) John Shea

OFFICE USE ONLY

EWM

SEC.

1/4

1/4

1/4