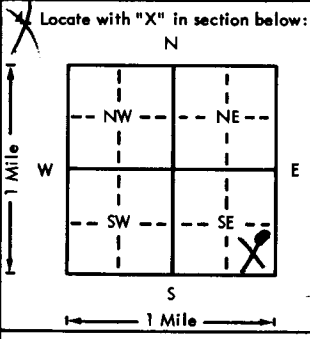
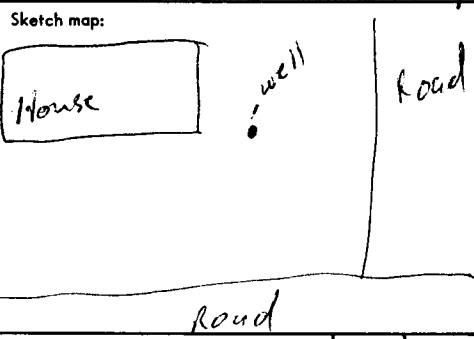


USE TYPEWRITER OR BALL POINT PEN-PRESS FIRMLY, PRINT CLEARLY.

WATER WELL RECORD
KSA 82a-1201-1215

Kansas Department of Health and Environment-Division of Environment
(Water well Contractors)
Topeka, Kansas 66620

1. Location of well: County Ellis Section SE Section number 28 Township number T 12 S R 18 E	
2. Distance and direction from nearest town or city: 7 North of Hays 3. Owner of well: Don Hurst Street address of well location if in city: Hays, Kansas 67601 City, state, zip code: Hays, Kansas 67601	
4. Locate with "X" in section below:  Sketch map: 	
6. Bore hole dia. 9 in. Completion date 9/4/75 Well depth 70 ft.	
7. <input checked="" type="checkbox"/> Cable tool <input checked="" type="checkbox"/> Rotary <input type="checkbox"/> Driven <input type="checkbox"/> Dug <input type="checkbox"/> Hollow rod <input type="checkbox"/> Jetted <input type="checkbox"/> Bored <input type="checkbox"/> Reverse rotary	
8. Use: <input type="checkbox"/> Domestic <input type="checkbox"/> Public supply <input type="checkbox"/> Industry <input type="checkbox"/> Irrigation <input type="checkbox"/> Air conditioning <input type="checkbox"/> Stock <input checked="" type="checkbox"/> Lawn <input type="checkbox"/> Oil field water <input type="checkbox"/> Other	
9. Casing: Material PVC Height Above or below Threaded <input type="checkbox"/> Welded <input checked="" type="checkbox"/> Surface 20 in. RMP <input type="checkbox"/> PVC <input checked="" type="checkbox"/> Weight 2.8 lbs./ft. Dia. 5 in. to 70 ft. depth Wall Thickness: <input type="checkbox"/> inch or Dia. <input type="checkbox"/> in. to <input type="checkbox"/> ft. depth gage No. 250	
10. Screen: Manufacturer's name Jet Stream Type PVC Dia. 5" Slot/gauze <input checked="" type="checkbox"/> Length 11' Set between 59 ft. and 70 ft. Gravel pack? <input checked="" type="checkbox"/> Size range of material 1/4-1/2	
11. Static water level: 56.2 ft. below land surface Date 9/4/75	
12. Pumping level below land surfaces: 62 ft. after 12 hrs. pumping 20 g.p.m. <input type="checkbox"/> ft. after <input type="checkbox"/> hrs. pumping <input type="checkbox"/> g.p.m. Estimated maximum yield 20 g.p.m.	
13. Water sample submitted: <input type="checkbox"/> Yes <input checked="" type="checkbox"/> No Date <input type="checkbox"/>	
14. Well head completion: <input checked="" type="checkbox"/> Pitless adapter <input type="checkbox"/> inches above grade	
15. Well grouted? <input checked="" type="checkbox"/> Yes With: <input type="checkbox"/> Neat cement <input type="checkbox"/> Bentonite <input checked="" type="checkbox"/> Concrete Depth: From 5 ft. to 13 ft.	
16. Nearest source of possible contamination: None ft. <input type="checkbox"/> Direction <input type="checkbox"/> Type <input type="checkbox"/> Well disinfected upon completion? <input checked="" type="checkbox"/> Yes <input type="checkbox"/> No	
17. Pump: <input type="checkbox"/> Not installed Manufacturer's name Valley Model number 51811 HP 1 Volts 220 Length of drop pipe 65 ft. capacity 20 g.p.m. Type: <input checked="" type="checkbox"/> Submersible <input type="checkbox"/> Turbine <input type="checkbox"/> Jet <input type="checkbox"/> Reciprocating <input type="checkbox"/> Centrifugal <input type="checkbox"/> Other	
18. Elevation: <input type="checkbox"/> Hill <input type="checkbox"/> Slope <input type="checkbox"/> Upland <input checked="" type="checkbox"/> Valley	
19. Remarks: None	
20. Water well contractor's certification: The well was drilled under my jurisdiction and this report is true to the best of my knowledge and belief. Karst Water Well 199A Business name Hwy 40 Hays License No. <input type="checkbox"/> Address H.E. King Date 9/4/75 Signed M.E. King Authorized representative	

T 12 S R 18 E
 Sec 28
 NESESE