


1 LOCATION OF WATER WELL: Fraction 1/4 SW 1/4 SW 1/4 Section Number 26 Township Number T 12 S Range Number R 18 EW

Distance and direction from nearest town or city street address of well if located within city?

50 W of Hays 1 East

2 WATER WELL OWNER: Dave Kruse
 RR#, St. Address, Box #: 1505 MARJORIEDA
 City, State, ZIP Code: HAYS KS 67601
 Board of Agriculture, Division of Water Resources
 Application Number:

3 LOCATE WELL'S LOCATION WITH AN "X" IN SECTION BOX:

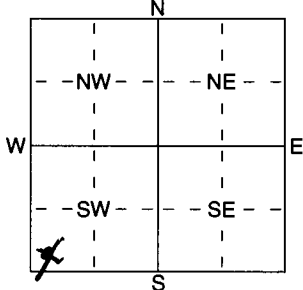

4 DEPTH OF COMPLETED WELL 35' ft. ELEVATION:

Depth(s) Groundwater Encountered 1 20' ft. 2 ft. 3 ft.
 WELL'S STATIC WATER LEVEL 10' ft. below land surface measured on mo/day/yr 5/16/04
 Pump test data: Well water was ft. after hours pumping gpm
 Est. Yield 5 gpm; Well water was ft. after hours pumping gpm
 WELL WATER TO BE USED AS:
 1 Domestic 3 Feedlot 5 Public water supply 8 Air conditioning 11 Injection well
 2 Irrigation 4 Industrial 6 Oil field water supply 9 Dewatering 12 Other (Specify below)
 7 Domestic (lawn & garden) 10 Monitoring well

Was a chemical/bacteriological sample submitted to Department? Yes No /; If yes, mo/day/yr sample was submitted
 Water Well Disinfected? Yes / No

5 TYPE OF BLANK CASING USED:
 1 Steel 3 RMP (SR) 5 Wrought iron 8 Concrete tile CASING JOINTS: Glued / Clamped
 2 PVC 4 ABS 6 Asbestos-Cement 9 Other (specify below) Welded
 7 Fiberglass Threaded

Blank casing diameter 5" in. to 35' ft., Dia in. to ft., Dia in. to ft.
 Casing height above land surface 15" in., weight 160 lbs./ft. Wall thickness or gauge No. SDR 26

TYPE OF SCREEN OR PERFORATION MATERIAL:
 1 Steel 3 Stainless Steel 5 Fiberglass 7 PVC 10 Asbestos-Cement
 2 Brass 4 Galvanized Steel 6 Concrete tile 8 RMP (SR) 11 Other (Specify)
 9 ABS 12 None used (open hole)

SCREEN OR PERFORATION OPENINGS ARE:
 1 Continuous slot 3 Mill slot 5 Gauzed wrapped 8 Saw cut 11 None (open hole)
 2 Louvered shutter 4 Key punched 6 Wire wrapped 9 Drilled holes
 7 Torch cut 10 Other (specify)

SCREEN-PERFORATED INTERVALS: From 35' ft. to 25' ft., From ft. to ft.
 GRAVEL PACK INTERVALS: From 35' ft. to 21' ft., From ft. to ft.
 From ft. to ft., From ft. to ft.

6 GROUT MATERIAL: 1 Neat cement 2 Cement grout 3 Bentonite 4 Other
 Grout Intervals: From 21' ft. to 0' ft., From ft. to ft., From ft. to ft.

What is the nearest source of possible contamination:
 1 Septic tank 4 Lateral lines 7 Pit privy 10 Livestock pens 14 Abandoned water well
 2 Sewer lines 5 Cess pool 8 Sewage lagoon 11 Fuel storage 15 Oil well/Gas well
 3 Watertight sewer lines 6 Seepage pit 9 Feedyard 12 Fertilizer storage 16 Other (specify below)
 13 Insecticide storage

Direction from well? 1000' + WEST How many feet?

FROM	TO	LITHOLOGIC LOG	FROM	TO	PLUGGING INTERVALS
0	8	TOP SOIL			
8	15	SAND + GRAVEL			
15	20	CLAY + SAND			
20	28	SAND			
28	35	SHALE			

7 CONTRACTOR'S OR LANDOWNER'S CERTIFICATION: This water well was (1) constructed, (2) reconstructed, or (3) plugged under my jurisdiction and was completed on (mo/day/year) 7/16/04 and this record is true to the best of my knowledge and belief. Kansas Water Well Contractor's Licence No 478 This Water Well Record was completed on (mo/day/yr) 5/16/04 under the business name of PENNWENSTEL WATER WELL by (signature) [Signature]