


1 LOCATION OF WATER WELL: Fraction NW 1/4 SW 1/4 SW 1/4 Section Number 32 Township Number T 12 S Range Number R 2 EW

Distance and direction from nearest town or city street address of well if located within city?
 5 miles south and 1 mile east of Bennington, KS

2 WATER WELL OWNER: Reed Holmes
 RR#, St. Address, Box #: 804 W. South Board of Agriculture, Division of Water Resources
 City, State, ZIP Code: Salina, KS 67401 Application Number:

3 LOCATE WELL'S LOCATION WITH AN "X" IN SECTION BOX:

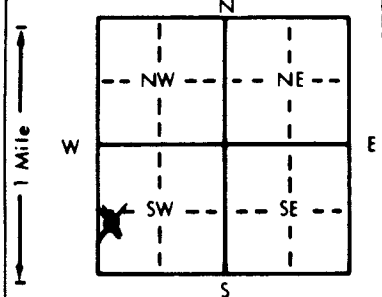

4 DEPTH OF COMPLETED WELL: 75 ft. ELEVATION:
 Depth(s) Groundwater Encountered 1. ft. 2. ft. 3. ft.
 WELL'S STATIC WATER LEVEL: 59 ft. below land surface measured on mo/day/yr 1/3/97.
 Pump test data: Well water was . . . ft. after . . . hours pumping . . . gpm
 Est. Yield .5-6. . . gpm: Well water was .65. . . ft. after .1/2. . . hours pumping .5. . . gpm
 Bore Hole Diameter: .8. . . in. to .75. . . ft., and . . . in. to . . . ft.
 WELL WATER TO BE USED AS: 5 Public water supply 8 Air conditioning 11 Injection well
 Domestic 3 Feedlot 6 Oil field water supply 9 Dewatering 12 Other (Specify below)
 2 Irrigation 4 Industrial 7 Lawn and garden only 10 Monitoring well
 Was a chemical/bacteriological sample submitted to Department? Yes. No. ; If yes, mo/day/yr sample was sub-
 mitted Water Well Disinfected? Yes No

5 TYPE OF BLANK CASING USED: 5 Wrought iron 8 Concrete tile CASING JOINTS: Glued . . . Clamped . . .
 1 Steel 3 RMP (SR) 6 Asbestos-Cement 9 Other (specify below) Welded
 PVC 4 ABS 7 Fiberglass Threaded

Blank casing diameter 5. in. to 65. ft., Dia in. to ft., Dia in. to ft.
 Casing height above land surface. 12 in., weight 2.37 lbs./ft. Wall thickness or gauge No. 214

TYPE OF SCREEN OR PERFORATION MATERIAL: PVC 10 Asbestos-cement
 1 Steel 3 Stainless steel 5 Fiberglass 8 RMP (SR) 11 Other (specify)
 2 Brass 4 Galvanized steel 6 Concrete tile 9 ABS 12 None used (open hole)

SCREEN OR PERFORATION OPENINGS ARE: 5 Gauzed wrapped 8 Saw cut 11 None (open hole)
 1 Continuous slot Mill slot 6 Wire wrapped 9 Drilled holes
 2 Louvered shutter 4 Key punched 7 Torch cut 10 Other (specify)

SCREEN-PERFORATED INTERVALS: From 65. ft. to 75. ft., From ft. to ft.
 From ft. to ft., From ft. to ft.

GRAVEL PACK INTERVALS: From 20. ft. to 75. ft., From ft. to ft.
 From ft. to ft., From ft. to ft.

6 GROUT MATERIAL: 1 Neat cement 2 Cement grout Bentonite 4 Other
 Grout Intervals: From 0. ft. to 20. ft., From ft. to ft., From ft. to ft.

What is the nearest source of possible contamination:
 1 Septic tank Lateral lines 7 Pit privy 10 Livestock pens 14 Abandoned water well
 2 Sewer lines 5 Cess pool 8 Sewage lagoon 11 Fuel storage 15 Oil well/Gas well
 3 Watertight sewer lines 6 Seepage pit 9 Feedyard 12 Fertilizer storage 16 Other (specify below)
 13 Insecticide storage

Direction from well? Southeast How many feet? 150

FROM	TO	LITHOLOGIC LOG	FROM	TO	PLUGGING INTERVALS
0	3	Top Soil			
3	5	Brown Clay			
5	8	Sandstone			
8	21	Brown Clay			
21	29	Blue Shale			
29	31	Red Sandstone			
31	49	Blue and white shale			
49	61	Red and yellow shale			
61	75	Tan sandstone			
75	76	Iron Rock			

7 CONTRACTOR'S OR LANDOWNER'S CERTIFICATION: This water well was (1) constructed, (2) reconstructed, or (3) plugged under my jurisdiction and was completed on (mo/day/year) 1/3/97 and this record is true to the best of my knowledge and belief. Kansas Water Well Contractor's License No. 138 This Water Well Record was completed on (mo/day/yr) 1/20/97 under the business name of Peterson Irrigation, Inc. by (signature) Mike Peters