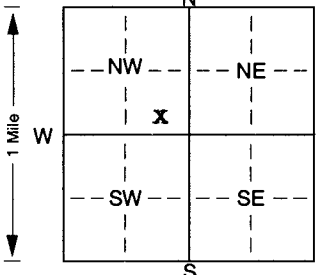


1 LOCATION OF WATER WELL: County: OTTAWA	Fraction SE 1/4 SE 1/4 NW 1/4	Section Number 35	Township Number T 12 S	Range Number R 2W EW
--	---	-----------------------------	----------------------------------	--------------------------------

Distance and direction from nearest town or city street address of well if located within city?
65 ASH LANE **OTTAWA COUNTY PERMIT #00-207**

2 WATER WELL OWNER: **MAX SHEPARD**
 RR#, St. Address, Box # : **65 ASH LANE** Board of Agriculture, Division of Water Resources
 City, State, ZIP Code : **BENNINGTON, KS. 67422** Application Number:

3 LOCATE WELL'S LOCATION WITH AN "X" IN SECTION BOX: 	4 DEPTH OF COMPLETED WELL: 137 ft. ELEVATION: 103 ft. Depth(s) Groundwater Encountered 1. 103 ft. 2. 103 ft. 3. 103 ft. WELL'S STATIC WATER LEVEL 103 ft. below land surface measured on mo/day/yr Pump test data: Well water was 113 ft. after 4 hours pumping 10 gpm Est. Yield 10000 118 gpm; Well water was 118 ft. after 4 hours pumping 30+ gpm Bore Hole Diameter: 9 in. to 142 ft. and 142 in. to 142 ft. WELL WATER TO BE USED AS: 5 Public water supply 8 Air conditioning 11 Injection well 1 Domestic 3 Feedlot 6 Oil field water supply 9 Dewatering 12 Other (Specify below) 2 Irrigation 4 Industrial <u>7 Domestic (lawn & garden)</u> 10 Monitoring well Was a chemical/bacteriological sample submitted to Department? Yes. <input type="checkbox"/> No. <input checked="" type="checkbox"/> X; If yes, mo/day/yrs sample was submitted Water Well Disinfected? Yes <input checked="" type="checkbox"/> X No <input type="checkbox"/>
--	--

5 TYPE OF BLANK CASING USED:
 1 Steel 3 RMP (SR) 5 Wrought iron 8 Concrete tile CASING JOINTS: Glued. X Clamped.
 2 PVC 4 ABS 6 Asbestos-Cement 9 Other (specify below) Welded.
 7 Fiberglass Threaded.
 Blank casing diameter **5** in. to **117** ft., Dia. **160** in. to **160** ft., Dia. **160** in. to **160** ft.
 Casing height above land surface **18** in., weight **160** lbs./ft. Wall thickness or gauge No. **SDR 26**
 TYPE OF SCREEN OR PERFORATION MATERIAL:
 1 Steel 3 Stainless steel 5 Fiberglass 7 PVC 10 Asbestos-cement
 2 Brass 4 Galvanized steel 6 Concrete tile 8 RMP (SR) 11 Other (specify)
 9 ABS 12 None used (open hole)
 SCREEN OR PERFORATION OPENINGS ARE:
 1 Continuous slot 3 Mill slot .025 5 Gauzed wrapped 8 Saw cut 11 None (open hole)
 2 Louvered shutter 4 Key punched 7 Torch cut 9 Drilled holes 10 Other (specify)
 SCREEN-PERFORATED INTERVALS: From **117** ft. to **137** ft., From ft. to ft.
 From ft. to ft., From ft. to ft.
 GRAVEL PACK INTERVALS: From **36** ft. to **87** ft., From **90** ft. to **137** ft.
 From ft. to ft., From ft. to ft.

6 GROUT MATERIAL: 1 Neat cement 2 Cement grout 3 Bentonite 4 Other
 Grout Intervals: From **0** ft. to **36** ft., From **87** ft. to **90** ft., From ft. to ft.
 What is the nearest source of possible contamination:
 1 Septic tank 4 Lateral lines 7 Pit privy 10 Livestock pens 14 Abandoned water well
 2 Sewer lines 5 Cess pool 8 Sewage lagoon 11 Fuel storage 15 Oil well/Gas well
 3 Watertight sewer lines 6 Seepage pit 9 Feedyard 12 Fertilizer storage 16 Other (specify below)
 13 Insecticide storage
 Direction from well? **WEST** How many feet? **145**

FROM	TO	LITHOLOGIC LOG	FROM	TO	PLUGGING INTERVALS
0	1	TOP SOIL			
1	36	SANDSTONE RED			
36	98	CLAY TAN TO LIGHT GRAY TO RED			
98	136	SANDSTONE LIGHT GRAY FINE GRAIN			
136	142	SHALE GRAY			

7 CONTRACTOR'S OR LANDOWNER'S CERTIFICATION: This water well was (1) constructed, (2) reconstructed, or (3) plugged under my jurisdiction and was completed on (mo/day/year) **7-26-00** and this record is true to the best of my knowledge and belief. Kansas Water Well Contractor's Licence No. **388** This Water Well Record was completed on (mo/day/yr) **7-28-00** under the business name of **PESTINGER PUMP SERVICE** by (signature) *Paul Pestinger*