


1 LOCATION OF WATER WELL: Fraction NE 1/4 SE 1/4 SE 1/4 Section Number 1 Township Number T 12 S Range Number R 2  W  
 County: Ottawa  
 Distance and direction from nearest town or city street address of well if located within city?  
In city limits, 111 West Lexington, Bennington

2 WATER WELL OWNER: Tom Tipton  
 RR#, St. Address, Box # : 111 West Lexington Board of Agriculture, Division of Water Resources  
 City, State, ZIP Code : Bennington, KS 67422 Application Number:

3 LOCATE WELL'S LOCATION WITH AN "X" IN SECTION BOX:

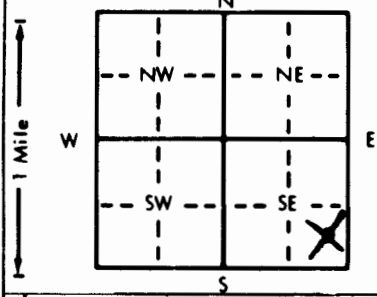

4 DEPTH OF COMPLETED WELL... 49 ft. ELEVATION: .....  
 Depth(s) Groundwater Encountered 1. .... 26 ..... ft. 2. .... ft. 3. .... ft.  
 WELL'S STATIC WATER LEVEL ... 26 ..... ft. below land surface measured on mo/day/yr 10-14-91 .....  
 Pump test data: Well water was ..... ft. after ..... hours pumping ..... gpm  
 Est. Yield 1.2-2.5 gpm: Well water was 35 ..... ft. after 1 ..... hours pumping 1.2 ..... gpm  
 Bore Hole Diameter... 8 ..... in. to 5.1 ..... ft., and ..... in. to ..... ft.  
 WELL WATER TO BE USED AS: 5 Public water supply 8 Air conditioning 11 Injection well  
 1 Domestic 3 Feedlot 6 Oil field water supply 9 Dewatering 12 Other (Specify below)  
 2 Irrigation 4 Industrial 7 Lawn and garden only 10 Monitoring well .....  
 Was a chemical/bacteriological sample submitted to Department? Yes.....No........; If yes, mo/day/yr sample was sub-  
 mitted Water Well Disinfected? Yes  No

5 TYPE OF BLANK CASING USED: 5 Wrought iron 8 Concrete tile CASING JOINTS: Glued  Clamped .....  
 1 Steel 3 RMP (SR) 6 Asbestos-Cement 9 Other (specify below) Welded .....  
 2 PVC 4 ABS 7 Fiberglass Threaded.....  
 Blank casing diameter ... 5 ..... in. to 3.9 ..... ft., Dia ..... in. to ..... ft., Dia ..... in. to ..... ft.  
 Casing height above land surface..... 12 ..... in., weight ..... 2.37 ..... lbs./ft. Wall thickness or gauge No. ... 21.4 .....  
 TYPE OF SCREEN OR PERFORATION MATERIAL: 7 PVC 10 Asbestos-cement  
 1 Steel 3 Stainless steel 5 Fiberglass 8 RMP (SR) 11 Other (specify) .....  
 2 Brass 4 Galvanized steel 6 Concrete tile 9 ABS 12 None used (open hole)  
 SCREEN OR PERFORATION OPENINGS ARE: 5 Gauzed wrapped 8 Saw cut 11 None (open hole)  
 1 Continuous slot 3 Mill slot 6 Wire wrapped 9 Drilled holes  
 2 Louvered shutter 4 Key punched 7 Torch cut 10 Other (specify) .....  
 SCREEN-PERFORATED INTERVALS: From... 39 ..... ft. to 49 ..... ft., From ..... ft. to ..... ft.  
 From ..... ft. to ..... ft., From ..... ft. to ..... ft.  
 GRAVEL PACK INTERVALS: From... 25 ..... ft. to 49 ..... ft., From ..... ft. to ..... ft.  
 From ..... ft. to ..... ft., From ..... ft. to ..... ft.

6 GROUT MATERIAL: 1 Neat cement 2 Cement grout 3 Bentonite 4 Other .....  
 Grout Intervals: From... 5 ..... ft. to 25 ..... ft., From ..... ft. to ..... ft., From ..... ft. to ..... ft.  
 What is the nearest source of possible contamination: 10 Livestock pens 14 Abandoned water well  
 1 Septic tank 4 Lateral lines 7 Pit privy 11 Fuel storage 15 Oil well/Gas well  
 2 Sewer lines 5 Cess pool 8 Sewage lagoon 12 Fertilizer storage 16 Other (specify below)  
 3 Watertight sewer lines 6 Seepage pit 9 Feedyard 13 Insecticide storage .....  
 Direction from well? North How many feet? 75 ft

FROM	TO	LITHOLOGIC LOG	FROM	TO	PLUGGING INTERVALS
0	3	Top Soil			
3	5	Sandy Brown Clays			
5	12	Fine Brown Sand			
12	27	Brown Clay			
27	34	Silty Tan Clay			
34	42	Fine Clean Sand			
42	50	Brown Clay & Sand layers			
50	51	Shale			

7 CONTRACTOR'S OR LANDOWNER'S CERTIFICATION: This water well was (1) constructed, (2) reconstructed, or (3) plugged under my jurisdiction and was completed on (mo/day/year) ..... 10-14-91 ..... and this record is true to the best of my knowledge and belief. Kansas Water Well Contractor's License No. .... 138 ..... This Water Well Record was completed on (mo/day/yr) ..... 10-15-91 ..... under the business name of Peterson Irrigation, Inc. by (signature) Mike Peterson