USE TYPEWRITER OR BALL POINT PEN-PRESS FIRMLY, PRINT CLEARLY.

WATER WELL RECORD
KSA 82a-1201-1215

Kansas Department of Health and Environment-Division of Environment
(Water well Contractors)
Topeka, Kansas 66620

1. Location of well:	County	Fraction	Section number	Township number	Range number
	Ellis	SW 1/4 SW 1/4 NW 1/4	22	T 12 S	R 20 E (W)

2. Distance and direction from nearest town or city: Ellis 3 N. 1 East 1/2 north
Street address of well location if in city:

3. Owner of well: Wes Bittle
R.R. or street: R. 3
City, state, zip code: Ellis, Ks. 67637

4. Locate with "X" in section below: Sketch map:

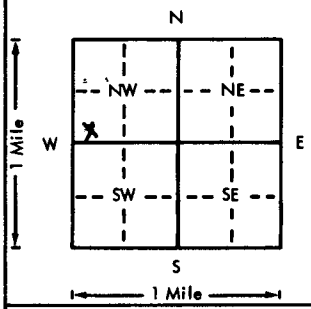

drilled in pasture

6. Bore hole dia. 10 in. Completion date Oct 10-77
Well depth 35 ft.

7. __ Cable tool X Rotary __ Driven __ Dug
__ Hollow rod __ Jetted __ Bored __ Reverse rotary

8. Use: X Domestic __ Public supply __ Industry
__ Irrigation __ Air conditioning __ Stock
__ Lawn __ Oil field water __ Other

9. Casing: Material Pets Height: (Above) or below
Threaded ___ Welded gl. Surface 18 in.
RMP ___ PVC ___ Weight .025 lbs./ft.
Dia. 5 in. to 15 ft. depth Wall Thickness: inches or
Dia. ___ in. to ___ ft. depth gage No. .025 (4)

5. Type and color of material	From	To
0-12 top soil	0	12
Coarse red sand + Yellow Rock	12	30
Blue Shale	30	35

(Use a second sheet if needed)

10. Screen: Manufacturer's name Jesse T Lowell
Type Pets pipe Dia. 5
(Slot) gauze 14 Length 20
Set between 15 ft. and 35 ft.
___ ft. and ___ ft.
Gravel pack? X Size range of material 1/8 - 1/4"

11. Static water level: mo./day/yr.
16 ft. below land surface Date Oct 10-77

12. Pumping level below land surfaces:
16 ft. after 1/2 hrs. pumping 8 g.p.m.
20 ft. after 1 hrs. pumping 12 g.p.m.
Estimated maximum yield 15 g.p.m.

13. Water sample submitted: mo./day/yr.
__ Yes X No Date

14. Well head completion:
__ Pitless adapter ___ Inches above grade

15. Well grouted? ___
With: X Neat cement ___ Bentonite ___ Concrete
Depth: From 0 ft. to 10 ft.

16. Nearest source of possible contamination:
ft. 2640 Direction N. Type Sewer
Well disinfected upon completion? X Yes ___ No

17. Pump: ___ Not installed
Manufacturer's name
Model number — HP 1/3 Volts 115
Length of drop pipe 32 ft. capacity 5 g.p.m.
Type: Pump Jack.
__ Submersible __ Turbine
__ Jet __ Reciprocating
__ Centrifugal __ Other

T 12 R 20 E (W) Sec 22 1/4 SW 1/4 SW 1/4 NW

18. Elevation:
Topography:
__ Hill
X Slope
__ Upland
__ Valley

19. Remarks:

20. Water well contractor's certification:
This well was drilled under my jurisdiction and this report is true to the best of my knowledge and belief.
Lyon Water Well Drilling
Business name License No. 276
Address 503 Monroe
Signed John Lyon Date Oct 10 77
Authorized representative

Forward the white, blue and pink copies to the Department of Health and Environment

Form WWC-5

M1-1023