


WATER WELL RECORD Form WWC-5 KSA 82a-1212

1 LOCATION OF WATER WELL: County: ELLIS Fraction: SE 1/4 SE 1/4 SE 1/4 Section Number: 21 Township Number: T 12 S Range Number: R 20 B/W

Distance and direction from nearest town or city street address of well if located within city?
2 1/2 North and 1 East of Ellis KS

2 WATER WELL OWNER: MELVIN RIEDEL
RR#, St. Address, Box # : 617 W 11th Board of Agriculture, Division of Water Resources
City, State, ZIP Code : ELLIS KS 67637 Application Number:

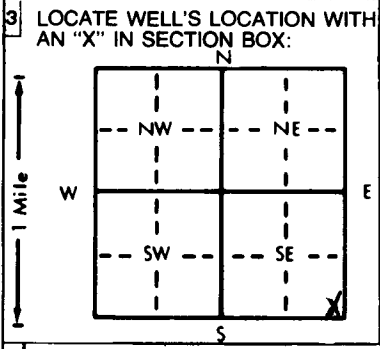

4 DEPTH OF COMPLETED WELL: 62 ft. ELEVATION:
Depth(s) Groundwater Encountered 1. 48 ft. 2. ft. 3. ft.
WELL'S STATIC WATER LEVEL 30 ft. below land surface measured on mo/day/yr 12-12-01
Pump test data: Well water was ft. after hours pumping gpm
Est. Yield 4 gpm: Well water was ft. after hours pumping gpm
Bore Hole Diameter 10 in. to 62 ft., and in. to ft.
WELL WATER TO BE USED AS: 5 Public water supply 8 Air conditioning 11 Injection well
XX Domestic 3 Feedlot 6 Oil field water supply 9 Dewatering 12 Other (Specify below)
2 Irrigation 4 Industrial 7 Lawn and garden only 10 Monitoring well
Was a chemical/bacteriological sample submitted to Department? Yes No XX; If yes, mo/day/yr sample was submitted
Water Well Disinfected? Yes No XX

5 TYPE OF BLANK CASING USED: 5 Wrought iron 8 Concrete tile CASING JOINTS: Glued XX Clamped
1 Steel 3 RMP (SR) 6 Asbestos-Cement 9 Other (specify below) Welded
XX PVC 4 ABS 7 Fiberglass Threaded
Blank casing diameter 5 in. to 42 ft., Dia in. to ft., Dia in. to ft.
Casing height above land surface 18 in., weight 160 lbs./ft. Wall thickness or gauge No.
TYPE OF SCREEN OR PERFORATION MATERIAL: XX PVC 10 Asbestos-cement
1 Steel 3 Stainless steel 5 Fiberglass 8 RMP (SR) 11 Other (specify)
2 Brass 4 Galvanized steel 6 Concrete tile 9 ABS 12 None used (open hole)
SCREEN OR PERFORATION OPENINGS ARE: 5 Gauzed wrapped 8 Saw cut 11 None (open hole)
1 Continuous slot XX Mill slot 6 Wire wrapped 9 Drilled holes
2 Louvered shutter 4 Key punched 7 Torch cut 10 Other (specify)
SCREEN-PERFORATED INTERVALS: From 42 ft. to 62 ft., From ft. to ft.
GRAVEL PACK INTERVALS: From 40 ft. to 62 ft., From ft. to ft.

6 GROUT MATERIAL: 1 Neat cement 2 Cement grout XX Bentonite 4 Other
Grout intervals: From 0 ft. to 30 ft., From ft. to ft., From ft. to ft.
What is the nearest source of possible contamination:
1 Septic tank 4 Lateral lines 7 Pit privy 10 Livestock pens 14 Abandoned water well
2 Sewer lines 5 Cess pool 8 Sewage lagoon 11 Fuel storage 15 Oil well/Gas well
3 Watertight sewer lines 6 Seepage pit 9 Feedyard 12 Fertilizer storage 16 Other (specify below)
Direction from well? How many feet?

FROM	TO	LITHOLOGIC LOG	FROM	TO	PLUGGING INTERVALS
0	10	SURFACE CLAY			
10	40	YELLOW LIMESTONE			
40	50	GRAY CLAY			
50	52	WATER BEARING ROCK			
52	62	BLUE SHALE			

7 CONTRACTOR'S OR LANDOWNER'S CERTIFICATION: This water well was XX constructed, (2) reconstructed, or (3) plugged under my jurisdiction and was completed on (mo/day/year) 12-17-01 and this record is true to the best of my knowledge and belief. Kansas Water Well Contractor's License No. 444 This Water Well Record was completed on (mo/day/yr) 12-17-01 under the business name of ANDY ANDERSON DRILLING by (signature) Andy Anderson

INSTRUCTIONS: Use typewriter or ball point pen. PLEASE PRESS FIRMLY and PRINT clearly. Please fill in blanks, underline or circle the correct answers. Send top three copies to Kansas Department of Health and Environment, Bureau of Water, Topeka, Kansas 66620-0001. Telephone: 913-296-5545. Send one to WATER WELL OWNER and retain one for your records.

OFFICE USE ONLY
T
R
EW
SEC.
1/4
1/4
1/4