


1 LOCATION OF WATER WELL: County: Trego	Fraction NE 1/4 NE 1/4 NE 1/4	Section Number 4	Township Number T 12 S	Range Number R 21 W
---	---	----------------------------	----------------------------------	--

Distance and direction from nearest town or city street address of well if located within city?
 Approximately **4 1/2** miles east and **3 3/4** miles north of Ogallah

2 WATER WELL OWNER: RR#, St. Address, Box # : City, State, ZIP Code :	Trego County RWD #2 P.O. Box 155 WaKeeney, KS 67672	Board of Agriculture, Division of Water Resources Application Number:
---	--	--

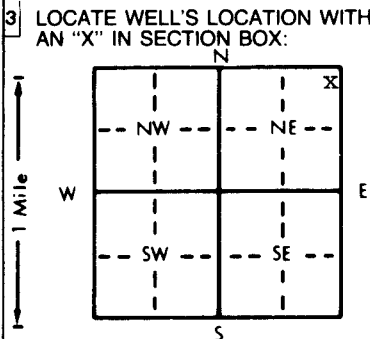

4 DEPTH OF COMPLETED WELL: 98 ft. ELEVATION: Unknown
Depth(s) Groundwater Encountered 1. ft. 2. ft. 3. ft.
WELL'S STATIC WATER LEVEL 63.75 ft. below land surface measured on mo/day/yr 8-21-97
Pump test data: Well water was not ch'd ft. after hours pumping gpm
Est. Yield unknown gpm: Well water was ft. after hours pumping gpm
Bore Hole Diameter 5 in. to 120 ft. and in. to ft.
WELL WATER TO BE USED AS: 5 Public water supply 8 Air conditioning 11 Injection well
1 Domestic 3 Feedlot 6 Oil field water supply 9 Dewatering 12 Other (Specify below)
2 Irrigation 4 Industrial 7 Lawn and garden only 10 <u>Monitoring well</u>
Was a chemical/bacteriological sample submitted to Department? Yes No <input checked="" type="checkbox"/> If yes, mo/day/yr sample was sub- mitted
Water Well Disinfected? Yes No <input checked="" type="checkbox"/>

5 TYPE OF BLANK CASING USED:	5 Wrought iron	8 Concrete tile	CASING JOINTS: Glued <input checked="" type="checkbox"/> Clamped
1 Steel 3 RMP (SR)	6 Asbestos-Cement	9 Other (specify below)	Welded
2 <u>PVC</u> 4 ABS	7 Fiberglass		Threaded
Blank casing diameter 2 in. to 89 ft., Dia in. to ft., Dia in. to ft.			
Casing height above land surface 24 in., weight 44 lbs./ft. Wall thickness or gauge No. .091			
TYPE OF SCREEN OR PERFORATION MATERIAL:	<u>7 PVC</u>	10 Asbestos-cement	
1 Steel 3 Stainless steel 5 Fiberglass 8 RMP (SR) 11 Other (specify)			
2 Brass 4 Galvanized steel 6 Concrete tile 9 ABS 12 None used (open hole)			
SCREEN OR PERFORATION OPENINGS ARE:	5 Gauzed wrapped	8 Saw cut	11 None (open hole)
1 Continuous slot <u>3 Mill slot</u> 6 Wire wrapped 9 Drilled holes			
2 Louvered shutter 4 Key punched 7 Torch cut 10 Other (specify)			
SCREEN-PERFORATED INTERVALS: From 89 ft. to 96 ft., From ft. to ft.			
GRAVEL PACK INTERVALS: From 84 ft. to 120 ft., From ft. to ft.			

6 GROUT MATERIAL:	1 Neat cement	2 Cement grout	3 Bentonite	4 Other <u>Bentonite Holeplug</u>
Grout Intervals: From ft. to ft., From ft. to ft., From 0 ft. to 84 ft.				
What is the nearest source of possible contamination:	10 Livestock pens	14 Abandoned water well		
1 Septic tank 4 Lateral lines 7 Pit privy 11 Fuel storage 15 Oil well/Gas well				
2 Sewer lines 5 Cess pool 8 Sewage lagoon 12 Fertilizer storage 16 Other (specify below)				
3 Watertight sewer lines 6 Seepage pit 9 Feedyard 13 Insecticide storage <u>None known</u>				
Direction from well?	How many feet?			

FROM	TO	LITHOLOGIC LOG	FROM	TO	PLUGGING INTERVALS
0	4	Topsoil			
4	11	Clay, tan, hard, limestone streaks			
11	25	Sand and gravel, coarse, medium, fine			
25	32	Sand with hard cemented streaks			
32	55	Clay, green, ahrd			
55	76	Sand and gravel, coarse, medium, fine			
76	89	Clay, white, soft, sandy			
89	96	Sand and gravel, medium, fine			
96	106	Clay, brown and white			
106	111	Clay, dark gray, hard			
111	120	Shale, black, hard			

7 CONTRACTOR'S OR LANDOWNER'S CERTIFICATION: This water well was (1) <u>constructed</u> , (2) reconstructed, or (3) plugged under my jurisdiction and was completed on (mo/day/year) 8-21-97 and this record is true to the best of my knowledge and belief. Kansas Water Well Contractor's License No. 185 This Water Well Record was completed on (mo/day/yr) 8-22-97 under the business name of Clarke Well & Equipment, Inc. by (signature) <i>Clarke Well & Equipment, Inc.</i>
--

INSTRUCTIONS: Use typewriter or ball point pen. PLEASE PRESS FIRMLY and PRINT clearly. Please fill in blanks, underline or circle the correct answers. Send top three copies to Kansas Department of Health and Environment, Bureau of Water, Topeka, Kansas 66620-0001. Telephone: 913-296-5545. Send one to WATER WELL OWNER and retain one for your records.

OFFICE USE ONLY T R EW SEC 1/4 1/4 1/4