


1 LOCATION OF WATER WELL: County: TRE90 Fraction: SW 1/4 SW 1/4 SE 1/4 Section Number: 12 Township Number: T 12 S Range Number: R 22 E(W)

Distance and direction from nearest town or city street address of well if located within city?  
1/2 m. East 1/2 North 1/2 East of Ogallah Ks 67656

2 WATER WELL OWNER: Lois SHERFICK  
 RR#, St. Address, Box #: HC 2  
 City, State, ZIP Code: Ogallah Ks 67656  
 Board of Agriculture, Division of Water Resources  
 Application Number:

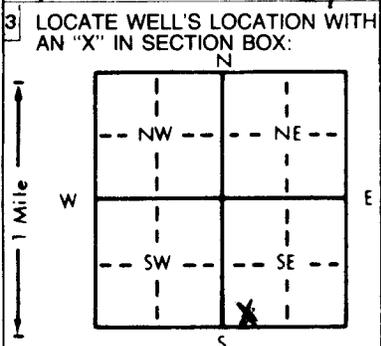

4 DEPTH OF COMPLETED WELL: 102 ft. ELEVATION:  
 Depth(s) Groundwater Encountered 1. 72 ft. 2. ft. 3. ft.  
 WELL'S STATIC WATER LEVEL 70 ft. below land surface measured on mo/day/yr 3/28/96  
 Pump test data: Well water was 27 ft. after 1.5 hours pumping 20 gpm  
 Est. Yield 20 gpm: Well water was ft. after hours pumping gpm  
 Bore Hole Diameter: 10 in. to ft., and in. to ft.  
 WELL WATER TO BE USED AS:  
 1 Domestic     3 Feedlot     6 Oil field water supply     9 Dewatering     12 Other (Specify below)  
 2 Irrigation     4 Industrial     7 Lawn and garden only     10 Monitoring well  
 Was a chemical/bacteriological sample submitted to Department? Yes.....No..... If yes, mo/day/yr sample was submitted  
 Water Well Disinfected?  Yes     No

5 TYPE OF BLANK CASING USED:  
 1 Steel     3 RMP (SR)  
 2 PVC     4 ABS  
 5 Wrought iron     8 Concrete tile    CASING JOINTS:  Glued     Clamped  
 6 Asbestos-Cement     9 Other (specify below)     Welded  
 7 Fiberglass     Threaded  
 Blank casing diameter 5 in. to ft., Dia. in. to ft., Dia. in. to ft.  
 Casing height above land surface in., weight lbs./ft. Wall thickness or gauge No. SDR-26  
 TYPE OF SCREEN OR PERFORATION MATERIAL:  
 1 Steel     3 Stainless steel     5 Fiberglass     8 RMP (SR)     11 Other (specify)  
 2 Brass     4 Galvanized steel     6 Concrete tile     9 ABS     12 None used (open hole)  
 SCREEN OR PERFORATION OPENINGS ARE:  
 1 Continuous slot     3 Mill slot     5 Gauzed wrapped     8 Saw cut     11 None (open hole)  
 2 Louvered shutter     4 Key punched     6 Wire wrapped     9 Drilled holes  
 7 Torch cut     10 Other (specify)  
 SCREEN-PERFORATED INTERVALS: From 62 ft. to 102 ft., From ft. to ft.  
 From ft. to ft., From ft. to ft.  
 GRAVEL PACK INTERVALS: From 40 ft. to 102 ft., From ft. to ft.  
 From ft. to ft., From ft. to ft.

6 GROUT MATERIAL:  1 Neat cement     2 Cement grout     3 Bentonite     4 Other  
 Grout Intervals: From 4 ft. to 24 ft., From ft. to ft., From ft. to ft.  
 What is the nearest source of possible contamination:  
 1 Septic tank     4 Lateral lines     7 Pit privy     10 Livestock pens     14 Abandoned water well  
 2 Sewer lines     5 Cess pool     8 Sewage lagoon     11 Fuel storage     15 Oil well/Gas well  
 3 Watertight sewer lines     6 Seepage pit     9 Feedyard     12 Fertilizer storage     16 Other (specify below)  
 13 Insecticide storage  
 Direction from well? Northwest How many feet? 50-75

FROM	TO	LITHOLOGIC LOG	FROM	TO	PLUGGING INTERVALS
0	20	Top soil			
20	72	FINE GREY SAND			
72	75	HARD SANDSTONE			
75	99	FINE GREY SAND			
99	102	SHALE			

7 CONTRACTOR'S OR LANDOWNER'S CERTIFICATION: This water well was  (1) constructed, (2) reconstructed, or (3) plugged under my jurisdiction and was completed on (mo/day/year) 3/28/96 and this record is true to the best of my knowledge and belief. Kansas Water Well Contractor's License No. 276 This Water Well Record was completed on (mo/day/yr) 3/28/96 under the business name of KUEA Water Well Drilling by (signature) John Duce

OFFICE USE ONLY  
T  
R  
EW  
SEC.  
1/4  
1/4  
1/4