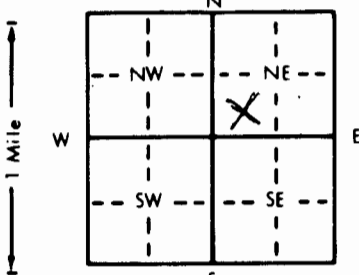


1 LOCATION OF WATER WELL: Fraction C 1/4 SW 1/4 NE 1/4 Section Number 23 Township Number T 12 S Range Number R 22 E/W
 County: Trego
 Distance and direction from nearest town or city street address of well if located within city?

2 WATER WELL OWNER: Robert Doxon
 RR#, St. Address, Box # HC 1 Box 4 Board of Agriculture, Division of Water Resources
 City, State, ZIP Code Ogallah, KS 67656 Application Number:

3 LOCATE WELL'S LOCATION WITH AN "X" IN SECTION BOX:  4 DEPTH OF COMPLETED WELL 110 ft. ELEVATION:
 Depth(s) Groundwater Encountered 1. 65 ft. 2. 110 ft. 3. 110 ft.
 WELL'S STATIC WATER LEVEL 65 ft. below land surface measured on mo/day/yr
 WELL WATER TO BE USED AS: 5 Public water supply 8 Air conditioning 11 Injection well
 1 Domestic 3 Feedlot 6 Oil field water supply 9 Dewatering 12 Other (Specify below)
 2 Irrigation 4 Industrial 7 Lawn and garden only 10 Monitoring well
 Was a chemical/bacteriological sample submitted to Department? Yes No X If yes, mo/day/yr sample was submitted
 Water Well Disinfected? Yes No X

5 TYPE OF CASING USED: 5 Wrought iron 8 Concrete tile CASING JOINTS: Glued X Clamped
 1 Steel 3 RMP (SR) 6 Asbestos-Cement 9 Other (specify below) Welded
 2 PVC 4 ABS 7 Fiberglass Threaded
 Blank casing diameter 4.5 in. to 70 ft., Dia in. to ft., Dia in. to ft.
 Casing height above land surface 18 in., weight 2.38 lbs./ft. Wall thickness or gauge No. 248
 TYPE OF SCREEN OR PERFORATION MATERIAL: 7 PVC 10 Asbestos-cement
 1 Steel 3 Stainless steel 5 Fiberglass 8 RMP (SR) 11 Other (specify)
 2 Brass 4 Galvanized steel 6 Concrete tile 9 ABS 12 None used (open hole)
 SCREEN OR PERFORATION OPENINGS ARE: 5 Gauzed wrapped 8 Saw cut 11 None (open hole)
 1 Continuous slot 3 Mill slot 6 Wire wrapped 9 Drilled holes
 2 Louvered shutter 4 Key punched 7 Torch cut 10 Other (specify)
 SCREEN-PERFORATED INTERVALS: From 70 ft. to 110 ft., From ft. to ft.
 From ft. to ft., From ft. to ft.
 GRAVEL PACK INTERVALS: From 20 ft. to 110 ft., From ft. to ft.
 From ft. to ft., From ft. to ft.

6 GROUT MATERIAL: 1 Neat cement 2 Cement grout 3 Bentonite 4 Other
 Grout Intervals: From 0 ft. to 20 ft., From ft. to ft., From ft. to ft.
 What is the nearest source of possible contamination: NONE 10 Livestock pens 14 Abandoned water well
 1 Septic tank 4 Lateral lines 7 Pit privy 11 Fuel storage 15 Oil well/Gas well
 2 Sewer lines 5 Cess pool 8 Sewage lagoon 12 Fertilizer storage 16 Other (specify below)
 3 Watertight sewer lines 6 Seepage pit 9 Feedyard 13 Insecticide storage

Direction from well? How many feet?

FROM	TO	LITHOLOGIC LOG	FROM	TO	PLUGGING INTERVALS
0	3	Surface	82	95	Clay & sand lenses
3	6	Loess	95	99	Sand & clay lenses
6	10	Silt & sand	99	105	Clay & fine sand lenses
10	21	Limestone & caliche	105	110	Ochre
21	43	Caliche, cemented sand & sandstone & sand lenses	110		Shale
43	44	Med sand			
44	50	Caliche			
50	52	Sand			
52	58	Cemented sand & sand lenses hard			
58	65	Sand			
65	66	Caliche			
66	70	Fine to med sand, clay lenses			
70	78	Sand & clay lenses			
78	82	Clay			

7 CONTRACTOR'S OR LANDOWNER'S CERTIFICATION: This water well was (1) constructed, (2) reconstructed, or (3) plugged under my jurisdiction and was completed on (mo/day/year) 7-26-97 and this record is true to the best of my knowledge and belief. Kansas Water Well Contractor's License No. 554 This Water Well Record was completed on (mo/day/yr) 7-30-97
 under the business name of Woofter Pump & Well, Inc. by (signature) [Signature]

INSTRUCTIONS: Use typewriter or ball point pen. PLEASE PRESS FIRMLY and PRINT clearly. Please fill in blanks, underline or circle the correct answers. Send top three copies to Kansas Department of Health and Environment, Bureau of Water, Topeka, Kansas 66620-0001. Telephone: 913-296-5545. Send one to WATER WELL OWNER and retain one for your records.

OFFICE USE ONLY
T
R
E/W
SEC.
1/4
1/4
1/4