


MW 2

1 LOCATION OF WATER WELL: Fraction NE 1/4 NE 1/4 NE 1/4 Section Number 17 Township Number T 12 S Range Number R 23 E/W

Distance and direction from nearest town or city street address of well if located within city?
I-70 & 283 Hwy, Wakeeney, Kansas

2 WATER WELL OWNER: RR#, St. Address, Box # Wakeeney Travel Plaza Attn: Larry Triplett Board of Agriculture, Division of Water Resources
 City, State, ZIP Code Box 647 Salina, KS 67402 Application Number: _____

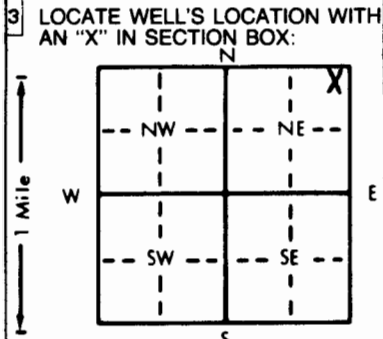

4 DEPTH OF COMPLETED WELL 95 ft. ELEVATION: _____
 Depth(s) Groundwater Encountered 1 80 ft. 2 _____ ft. 3 _____ ft.
 WELL'S STATIC WATER LEVEL 79.95 ft. below land surface measured on 6/14/95 mo/day/yr
 Pump test data: Well water was _____ ft. after _____ hours pumping _____ gpm
 Est. Yield _____ gpm: Well water was _____ ft. after _____ hours pumping _____ gpm
 Bore Hole Diameter 8.625 in. to 95 ft. and _____ in. to _____ ft.
 WELL WATER TO BE USED AS: 5 Public water supply 8 Air conditioning 11 Injection well
 1 Domestic 3 Feedlot 6 Oil field water supply 9 Dewatering 12 Other (Specify below)
 2 Irrigation 4 Industrial 7 Lawn and garden only 10 Monitoring well MW-2
 Was a chemical/bacteriological sample submitted to Department? Yes _____ No X; If yes, mo/day/yr sample was submitted _____
 Water Well Disinfected? Yes _____ No X

5 TYPE OF BLANK CASING USED: 1 Steel 3 RMP (SR) 5 Wrought iron 8 Concrete tile CASING JOINTS: Glued _____ Clamped _____
2 PVC 4 ABS 6 Asbestos-Cement 9 Other (specify below) Welded _____
 Blank casing diameter 2 in. to 6.9 ft. Dia _____ in. to _____ ft. Dia _____ in. to _____ ft.
 Casing height above land surface 0 in., weight SCH 40 PVC lbs./ft. Wall thickness or gauge No. _____
 TYPE OF SCREEN OR PERFORATION MATERIAL: 7 PVC 10 Asbestos-cement
 1 Steel 3 Stainless steel 5 Fiberglass 8 RMP (SR) 11 Other (specify) _____
 2 Brass 4 Galvanized steel 6 Concrete tile 9 ABS 12 None used (open hole)
 SCREEN OR PERFORATION OPENINGS ARE: 5 Gauzed wrapped 8 Saw cut 11 None (open hole)
 1 Continuous slot 3 Mill slot 6 Wire wrapped 9 Drilled holes
 2 Louvered shutter 4 Key punched 7 Torch cut 10 Other (specify) _____
 SCREEN-PERFORATED INTERVALS: From 6.9 ft. to 9.4 ft., From _____ ft. to _____ ft.
SAND From _____ ft. to _____ ft., From _____ ft. to _____ ft.
 GRAVEL PACK INTERVALS: From 6.7 ft. to 9.5 ft., From _____ ft. to _____ ft.
 From _____ ft. to _____ ft., From _____ ft. to _____ ft.

6 GROUT MATERIAL: 1 Neat cement 2 Cement grout 3 Bentonite 4 Other _____
 Grout Intervals: From 0 ft. to 6.5 ft., From 6.5 ft. to 6.7 ft., From _____ ft. to _____ ft.
 What is the nearest source of possible contamination: 10 Livestock pens 14 Abandoned water well
 1 Septic tank 4 Lateral lines 7 Pit privy 11 Fuel storage 15 Oil well/Gas well
 2 Sewer lines 5 Cess pool 8 Sewage lagoon 12 Fertilizer storage 16 Other (specify below)
 3 Watertight sewer lines 6 Seepage pit 9 Feedyard 13 Insecticide storage Contaminated site
 Direction from well? _____ How many feet? _____

FROM	TO	LITHOLOGIC LOG	FROM	TO	PLUGGING INTERVALS
GL	0.05	Asphalt			Flush Mount Wai
0.05	1.00	Fill			Don Taylor
1.00	18.00	Silt (ML)			5/5/95
18.00	24.00	Silty sand			
24.00	28.00	Silty Clay, some gravel and fine sand			
28.00	34.00	Caliche			
34.00	38.00	Silty clay			
38.00	46.00	Silty sand			
46.00	52.00	Sand, fine-med. grade			
52.00	62.00	Sand (SM)			
62.00	66.00	Clayey sand			
66.00	70.00	Caliche			
70.00	80.00	Sand (SM) fine to course grain			
80.00	95.00	sand, fine-course			

7 RECORDATOR'S OR OWNER'S DECLARATION: This water well was (1) constructed, (2) reconstructed, or (3) plugged under my jurisdiction and was completed on (mo/day/year) 5/30/95 and this record is true to the best of my knowledge and belief. Kansas Water Well Contractor's License No. 479 This Water Well Record was completed on (mo/day/yr) 6/15/95 under the business name of Associated Environmental, Inc. by (signature) DJohnson for Groger Ebberts

INSTRUCTIONS: Use typewriter or ball point pen. PLEASE PRESS FIRMLY and PRINT clearly. Please fill in blanks, underline or circle the correct answers. Send top three copies to Kansas Department of Health and Environment, Bureau of Water, Topeka, Kansas 66620-0001. Telephone: 913-296-5545. Send one to WATER WELL OWNER and retain one for your records.

OFFICE USE ONLY
T
R
E/W
SEC.
1/4
1/4
1/4