


MW 3

1 LOCATION OF WATER WELL: Fraction NE 1/4 NE 1/4 NE 1/4 Section Number 17 Township Number T 12 S Range Number R 23 E (W)
 County: Trego

Distance and direction from nearest town or city street address of well if located within city?
I-70 & 283 Hwy, Wakeeney, Kansas

2 WATER WELL OWNER: Wakeeney Travel Plaza Attn: Larry Triplett Board of Agriculture, Division of Water Resources
 RR#, St. Address, Box # Box 647 Salina, KS 67402 Application Number: -----
 City, State, ZIP Code

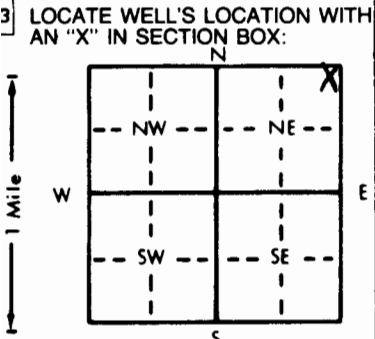

4 DEPTH OF COMPLETED WELL: 95 ft. ELEVATION: -----
 Depth(s) Groundwater Encountered 1. 78 ft. 2. ----- ft. 3. ----- ft.
 WELL'S STATIC WATER LEVEL: 77.47 ft. below land surface measured on mo/day/yr 6/14/95
 Pump test data: Well water was ----- ft. after ----- hours pumping ----- gpm
 Est. Yield ----- gpm Well water was ----- ft. after ----- hours pumping ----- gpm
 Bore Hole Diameter: 8.625 in. to 95 ft. and ----- in. to ----- ft.
 WELL WATER TO BE USED AS:
 5 Public water supply 8 Air conditioning 11 Injection well
 1 Domestic 3 Feedlot 6 Oil field water supply 9 Dewatering 12 Other (Specify below)
 2 Irrigation 4 Industrial 7 Lawn and garden only 10 Monitoring well MW-3
 Was a chemical/bacteriological sample submitted to Department? Yes ----- No X; If yes, mo/day/yr sample was submitted -----
 Water Well Disinfected? Yes ----- No X

5 TYPE OF BLANK CASING USED:
 1 Steel 3 RMP (SR) 5 Wrought iron 8 Concrete tile CASING JOINTS: Glued ----- Clamped -----
2 PVC 4 ABS 6 Asbestos-Cement 9 Other (specify below) Welded -----
 Blank casing diameter 2 in. to 60 ft., Dia ----- in. to ----- ft., Dia ----- in. to ----- ft.
 Casing height above land surface 0 in., weight SCH 40 PVC lbs./ft. Wall thickness or gauge No. -----
 TYPE OF SCREEN OR PERFORATION MATERIAL:
 1 Steel 3 Stainless steel 5 Fiberglass 8 RMP (SR) 10 Asbestos-cement
 2 Brass 4 Galvanized steel 6 Concrete tile 9 ABS 12 None used (open hole)
 SCREEN OR PERFORATION OPENINGS ARE:
 1 Continuous slot 3 Mill slot 5 Gauzed wrapped 8 Saw cut 11 None (open hole)
 2 Louvered shutter 4 Key punched 6 Wire wrapped 9 Drilled holes
 7 Torch cut 10 Other (specify) -----
 SCREEN-PERFORATED INTERVALS: From 60 ft. to 85 ft., From ----- ft. to ----- ft.
SAND From ----- ft. to ----- ft., From ----- ft. to ----- ft.
GRAVEL PACK INTERVALS: From 57 ft. to 95 ft., From ----- ft. to ----- ft.

6 GROUT MATERIAL: 1 Neat cement 2 Cement grout 3 Bentonite 4 Other -----
 Grout Intervals: From 0 ft. to 56 ft., From 56 ft. to 57 ft., From ----- ft. to ----- ft.
 What is the nearest source of possible contamination:
 1 Septic tank 4 Lateral lines 7 Pit privy 10 Livestock pens 14 Abandoned water well
 2 Sewer lines 5 Cess pool 8 Sewage lagoon 11 Fuel storage 15 Oil well/Gas well
 3 Watertight sewer lines 6 Seepage pit 9 Feedyard 12 Fertilizer storage 16 Other (specify below)
Contaminated site
 Direction from well? ----- How many feet? -----

FROM	TO	LITHOLOGIC LOG	FROM	TO	PLUGGING INTERVALS
GL	1.00	Asphalt			Flush Mount Wai
1.00	4.00	Fill, silty clay and gravel			Don Taylor
4.00	15.00	Silt (ML)			5/5/95
15.00	20.00	Silty sand (ML), some clay and gravel			
20.00	25.00	Silty caly			
25.00	32.00	Caliche			
32.00	38.00	Silty clay (CL)			
38.00	48.00	Sand with gravel, some silt			
48.00	56.00	Caliche, mod. to good cementation			
56.00	62.00	Sand (SM) fine-med grain			
62.00	64.50	Calishe, hard			
64.50	74.50	Sand (SM) some gravel			
74.50	95.00	Sand (SM) fine-course			
95.00	TD	End of Borehole			

7 CONTRACTOR'S OR LANDOWNER'S CERTIFICATION: This water well was (1) constructed, (2) reconstructed, or (3) plugged under my jurisdiction and was completed on (mo/day/year) 5/31/95 and this record is true to the best of my knowledge and belief. Kansas Water Well Contractor's License No. 479 This Water Well Record was completed on (mo/day/yr) 6/15/95 under the business name of Associated Environmental, Inc. by (signature) Dee Johnson for Grogan & Ebberts

INSTRUCTIONS: Use typewriter or ball point pen. PLEASE PRESS FIRMLY and PRINT clearly. Please fill in blanks, underline or circle the correct answers. Send top three copies to Kansas Department of Health and Environment, Bureau of Water, Topeka, Kansas 66620-0001. Telephone: 913-296-5545. Send one to WATER WELL OWNER and retain one for your records.

OFFICE USE ONLY
T
R
EMW
SEC.